


Township 17 S Range 4 W, W.M.  
North

*well*  
*irrigated land*

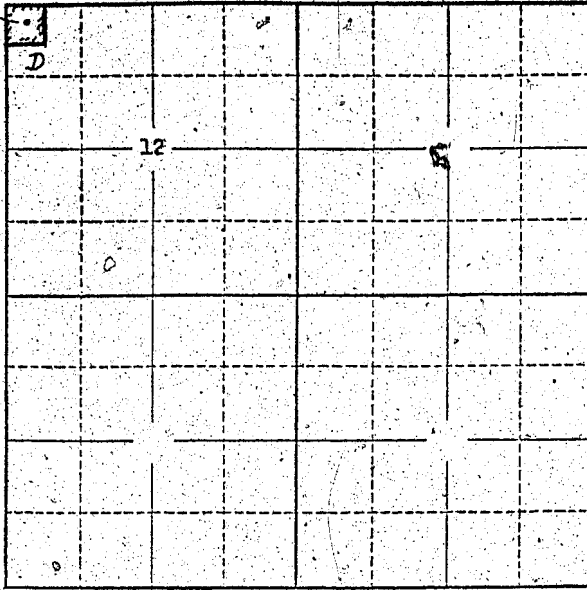

Locate well and acreage of irrigated land on plat.  
Scale: 2" = 1 Mile

STATE OF OREGON

County of Lane } ss.

I, James M. Blackford, being first duly sworn, do hereby certify that I have read the foregoing Registration Statement and that all of the items therein contained are true to the best of my knowledge and belief.

*James M Blackford*  
(Signature of Registrant)

Subscribed and sworn to before me this 1st day of August, 1958.

My commission expires 2-5-61

*R T Bausly*  
(Notary Public) for office

(SEAL)

CERTIFICATE OF REGISTRATION

STATE OF OREGON } ss.  
County of Marion

This is to certify that the foregoing Registration Statement was received in the office of the State Engineer on the 4 day of August, 1958, at 8:00 o'clock A.M. and has been duly recorded in said office in Book No. 17 of Registration Statements on page 4048

Witness my hand this 16th day of May, 1960

*Lewis A. Atkinson*  
(State Engineer)

By \_\_\_\_\_ (Deputy)

\$15.00

GR. 4048