


North

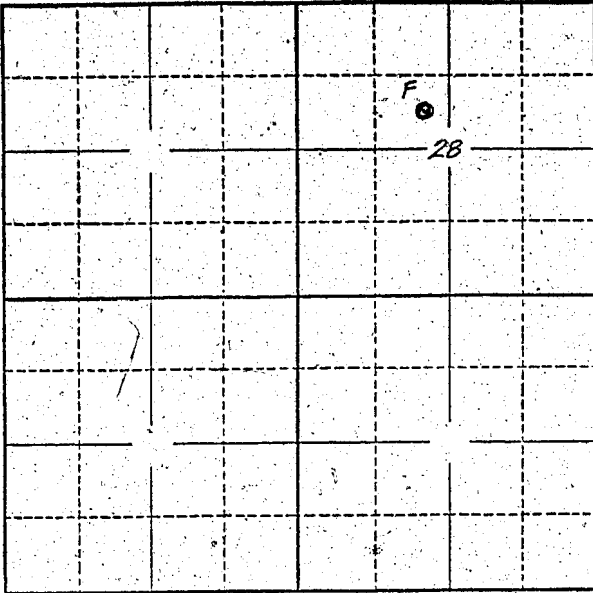

Locate well and acreage of irrigated land on plat.

Scale: 2" = 1 Mile

STATE OF OREGON

County of Lane } ss.

I, Rufus T. van Deinse, being first duly sworn; do hereby certify that I have read the foregoing Registration Statement and that all of the items therein contained are true to the best of my knowledge and belief.

Rufus T. van Deinse
(Signature of Registrant)

Subscribed and sworn to before me this 24th day of October, 1958.

My commission expires June 11, 1962
James M. Blackford
(Notary Public for Oregon)

(SEAL)

This filing was made on August 4, 1958 on an incorrect form. Data was later transferred to this registration statement and returned to this office on October 27, 1958.

CERTIFICATE OF REGISTRATION

STATE OF OREGON }
County of Marion } ss.

This is to certify that the foregoing Registration Statement was received in the office of the State Engineer on the 4th day of August, 1958, at 4:00 o'clock P.M. and has been duly recorded in said office in Book No. 16 of Registration Statements on page GR-3787

Witness my hand this 20th day of October, 1959
Stewart A. Stanley
(State Engineer)

\$ 17.25

By _____ (Deputy)