


North

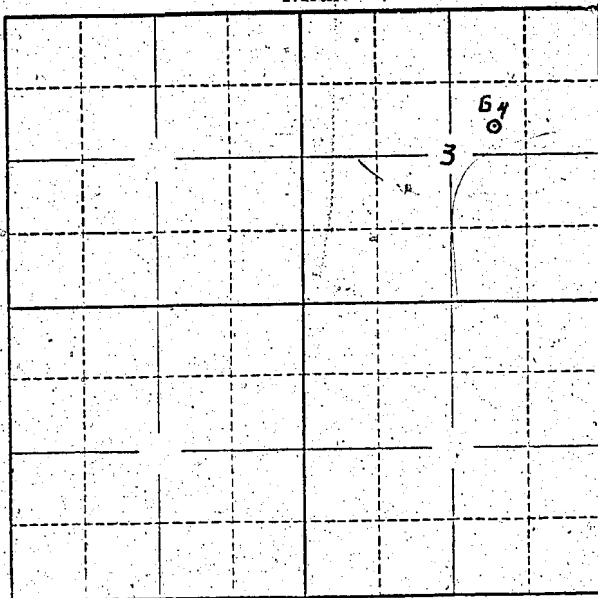

Locate well and acreage of irrigated land on plat.

Scale: 2" = 1 Mile

STATE OF OREGON

County of WASCO

ss.

I, George P. Stadelman, being first duly sworn, do hereby certify that I have read the foregoing Registration Statement and that all of the items therein contained are true to the best of my knowledge and belief.

STADELMAN ICE COMPANY

By George P. Stadelman
Partner. (Signature of Registrant)

Subscribed and sworn to before me this 3 day of August, 1961

My commission expires October 6, 1964.

J. Ireland Brown
(Notary Public) for Oregon

(SEAL)

CERTIFICATE OF REGISTRATION

STATE OF OREGON

County of Marion

ss.

This is to certify that the foregoing Registration Statement was received in the office of the State Engineer on the 4th day of August, 1961, at 8:00 o'clock A.M. and has been duly recorded in said office in Book No. 17 of Registration Statements on page 6R-4106

Witness my hand this 16th day of August, 1961

Lewis A. Stanley
(State Engineer)

By _____ (Deputy)

\$ 20.00