Township 1 N Range 1 W, W.M.

North

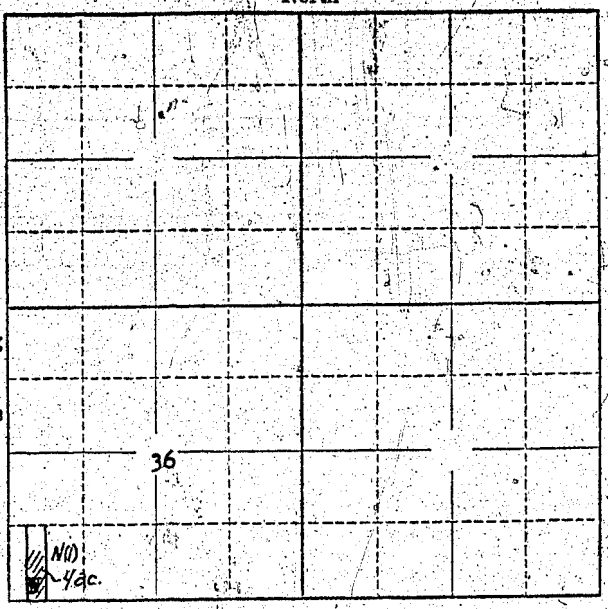

Rosary tract is 330' X 1320' with longest length running N - S.

West line of Rosary is 330' East of Section 36 West Line. Irrigated portion is South 4 acres of Rosary

Locate well and acreage of irrigated land on plat.

Scale: 2" = 1 Mile

STATE OF OREGON }
County of Multnomah } ss.

I, Wade Strowger, being first duly sworn, do hereby certify that I have read the foregoing Registration Statement and that all of the items therein contained are true to the best of my knowledge and belief.

Wade Strowger
(Signature of Registrant)

Subscribed and sworn to before me this 1st day of April, 1957.

Lucile B. Elliott
(Notary Public)

My commission expires Dec. 11, 1959

(SEAL)

My commission expires Dec. 11, 1959

CERTIFICATE OF REGISTRATION

STATE OF OREGON }
County of Marion } ss.

This is to certify that the foregoing Registration Statement was received in the office of the State Engineer on the 2nd day of April, 19 57, at 8:00 o'clock A. M. and has been duly recorded in said office in Book No. 3 of Registration Statements on page GR-412 C

XX ~~Construction shall be completed by X-X-X-X-X-X-X-X-X-X-19-X-X and the water completely applied to beneficial use by X-X-X-X-X-X-X-X-X-X-19-X-X-~~ XX

Witness my hand this 26th day of June, 19 57.

Lewis A. Stanley
(State Engineer)

$15.00

By
(Deputy)

GR - 412 C