


North

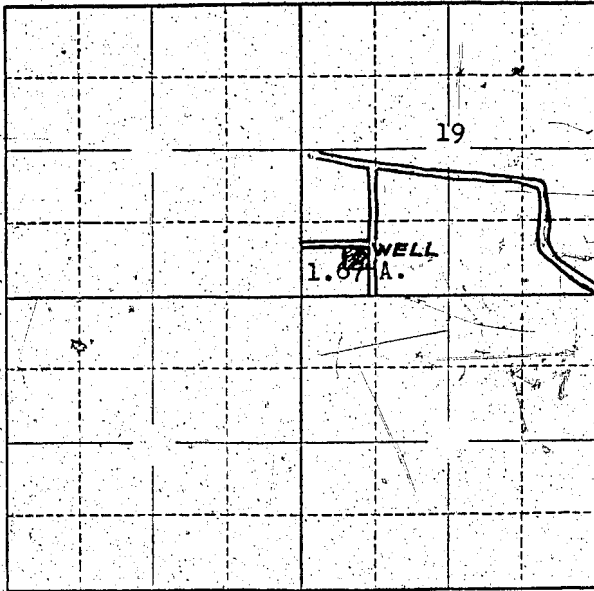

Locate well and acreage of irrigated land on plat.

Scale: 2" = 1 Mile

STATE OF OREGON

County of Clatsop

} ss.

I, Floyd E. Peterson, being first duly sworn, do hereby certify that I have read the foregoing Registration Statement and that all of the items therein contained are true to the best of my knowledge and belief.

Floyd E. Peterson  
(Signature of Registrant)

Subscribed and sworn to before me this 17th day of March, 1962

NOTARY PUBLIC FOR OREGON

My commission expires

My Commission Expires Nov 22 1964

W. H. ...  
(Notary Public)

(SEAL)

CERTIFICATE OF REGISTRATION

STATE OF OREGON

County of Marion

} ss.

This is to certify that the foregoing Registration Statement was received in the office of the State Engineer on the 30th day of March, 1962, at 8:00 o'clock A.M. and has been duly recorded in said office in Book No. 17 of Registration Statements on page GR-1118

Witness my hand this 25th day of April, 1962

LEWIS A. STANLEY

(State Engineer)

By W. H. ...

(Deputy)

GR-1118

\$15.00