Township 6 S Range 12 W, W.M.

North

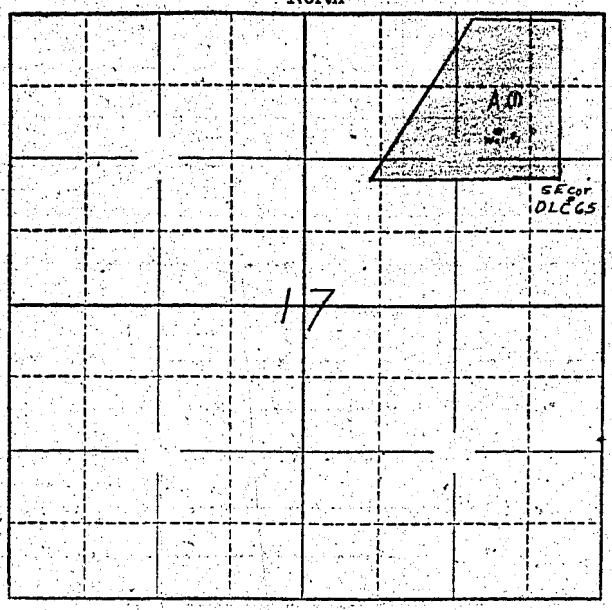

Well #1 1054'S & 956'W from NE cor sec. 17

Locate well and acreage of irrigated land on plat.

Scale: 2" = 1 Mile

STATE OF OREGON
County of Marion } ss.

I, N. D. Davidson, being first duly sworn, do hereby certify that I have read the foregoing Registration Statement and that all of the items therein contained are true to the best of my knowledge and belief.

N. D. Davidson
(Signature of Registrant)

Subscribed and sworn to before me this 14th day of August, 19 56.

NOTARY PUBLIC FOR OREGON
My commission expires My Commission Expires January 9, 1960
(Notary Public)

(SEAL)

See Page GR-413-G for
CERTIFICATE OF REGISTRATION

STATE OF OREGON
County of Marion } ss.

~~This is to certify that the foregoing Registration Statement was received in the office of the State Engineer on the x-x-x-x day of x-x-x-

Township 6 S Range 2 W, W.M.

North

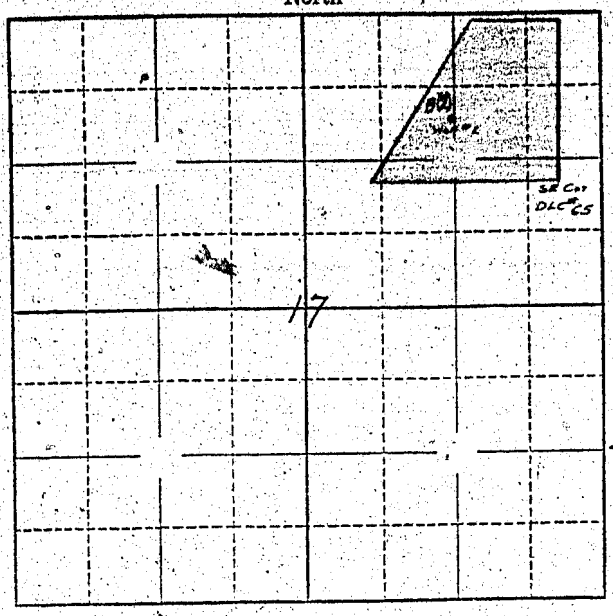

See Map in G-383

Locate well and acreage of irrigated land on plat.

Scale: 2" = 1 Mile

STATE OF OREGON
County of Marion } ss.

I, N. D. Davidson, being first duly sworn, do hereby certify that I have read the foregoing Registration Statement and that all of the items therein contained are true to the best of my knowledge and belief.

x N. D. Davidson
(Signature of Registrant)

Subscribed and sworn to before me this 14th day of August, 1956

NOTARY PUBLIC FOR OREGON
My Commission Expires Jan[illegible]

My commission expires [illegible]
(Notary Public)

(SEAL)

CERTIFICATE OF REGISTRATION

STATE OF OREGON
County of Marion } ss.

This is to certify that the foregoing Registration Statement was received in the office of the State Engineer on the 4th day of April, 1957, at 8:00 o'clock A. M. and has been duly recorded in said office in Book No. 3 of Registration Statements on page GR-413 G

~~Construction shall be completed by X-X-X-X-X-X-X-X-X-X-X-19-X-X-X and the water completely applied to beneficial use by X-X-X-X-X-X-X-X-X-X-X, 19-X-X-X~~

Witness my hand this 26th day of June, 1957

Lewis A. Stanley
(State Engineer)

By
(Deputy)

$20.00

GR - 413 G