


Township 5N Range 2W, W.M.
North

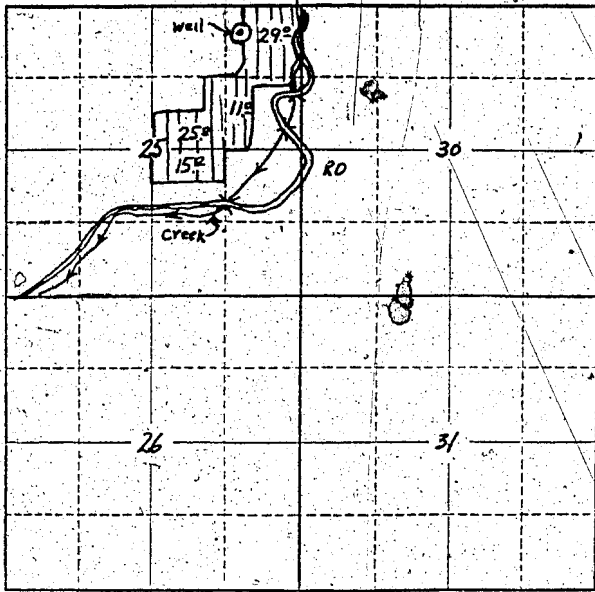

Locate well and acreage of irrigated land on plat.
Scale: 2" = 1 Mile

STATE OF OREGON

County of _____ } ss.

I, _____, being first duly sworn, do hereby certify that I have read the foregoing Registration Statement and that all of the items therein contained are true to the best of my knowledge and belief.

Fred L. Heston
Fred L. Heston
(Signature of Registrant)

Subscribed and sworn to before me this 31st day of May, 1962

My commission expires Aug. 24, 1962

Fred L. Heston
(Notary Public)

(SEAL)

CERTIFICATE OF REGISTRATION

STATE OF OREGON } ss.
County of Marion

This is to certify that the foregoing Registration Statement was received in the office of the State Engineer on the 7th day of May, 1962, at 8:00 o'clock A.M. and has been duly recorded in said office in Book No. 17 of Registration Statements on page GR-33

Witness my hand this 5th day of June, 1962

Charles T. Wheeler
(State Engineer)

By _____ (Deputy)

\$22.50