Township 36 S. Range 2 W., W.M.

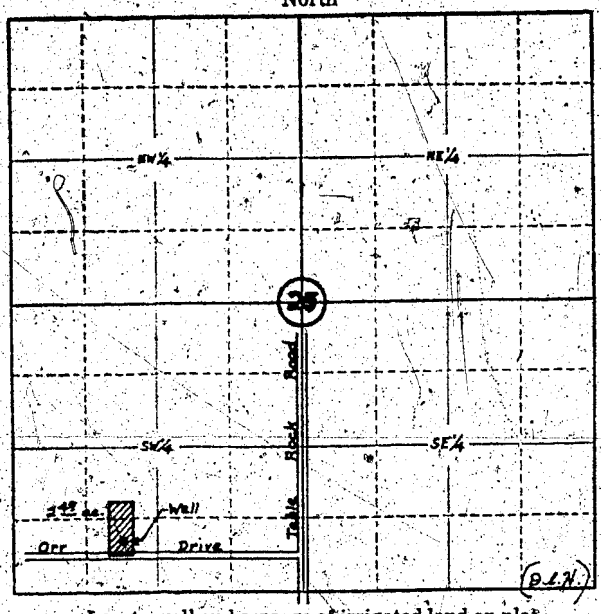

Locate well and acreage of irrigated land on plat.

Scale: 4" — 1 Mile

STATE OF OREGON
County of Jackson } ss.

I, Charles E. Myrick, being first duly sworn, do hereby certify that I have read the foregoing Registration Statement and that all of the items therein contained are true to the best of my knowledge and belief.

Charles E. Myrick
(Signature of Registrant)

Subscribed and sworn to before me this 11th day of July, 19 62

My commission expires Feb. 15, 1965 Phyllis Gilman
(Notary Public)

(SEAL)

CERTIFICATE OF REGISTRATION

STATE OF OREGON
County of Marion } ss.

This is to certify that the foregoing Registration Statement was received in the office of the State Engineer on the 13th day of July, 1962, at 8:00 o'clock A.M. and has been duly recorded in said office in Book No. 17 of Registration Statements on page GR-4128

Witness my hand this 13th day of July, 1962.

Lewis A. Rhodes
(State Engineer)

By
(Deputy)

GR 4128