


North

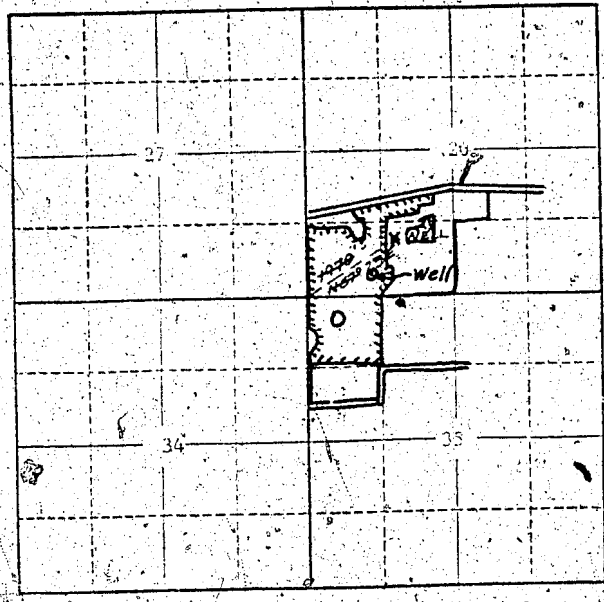

Locate well and acreage of irrigated land on plat. Scale: 2" = 1.Mile

STATE OF OREGON

County of Multnomah

I, Jack Bain, being first duly sworn, do hereby certify that I have read the foregoing Registration Statement and that all of the items therein contained are true to the best of my knowledge and belief.

BOARD OF COUNTY COMMISSIONERS OF MULTNOMAH COUNTY, OREGON

By: [Signature] Chairman

Subscribed and sworn to before me this 21st day of August, 1962

My commission expires NOTARY PUBLIC FOR OREGON

Commission Expires June 25, 1962

(Notary Public)

(SEAL)

CERTIFICATE OF REGISTRATION

STATE OF OREGON

County of Marion

This is to certify that the foregoing Registration Statement was received in the office of the State Engineer on the 8th day of August, 1962, at 8:00 o'clock A.M. and has been duly recorded in said office in Book No. 17 of Registration Statements on page GR 4131

Witness my hand this 16th day of October, 1962

[Signature] (State Engineer)

By: (Deputy)

\$34.60