


Township 2 Range 3E, W.M.
North

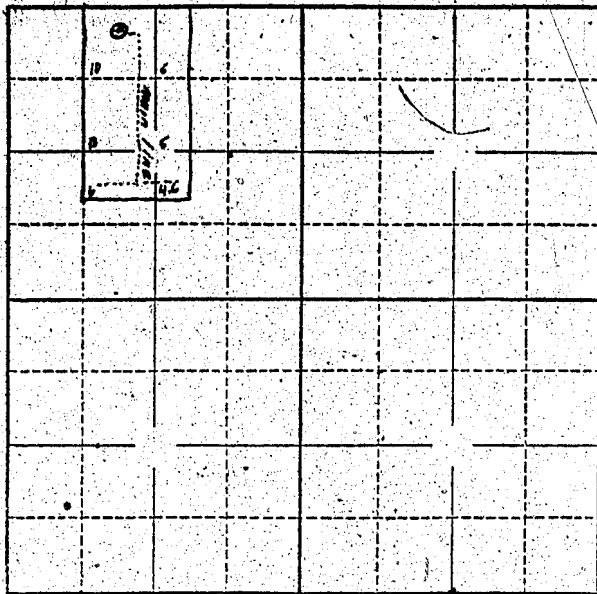

Locate well and acreage of irrigated land on plat.
Scale: 2" = 1 Mile

STATE OF OREGON

County of Clackamas } ss.

I, W. H. Markham, being first duly sworn, do hereby certify that I have read the foregoing Registration Statement and that all of the items therein contained are true to the best of my knowledge and belief.

W. H. Markham
(Signature of Registrant)

Subscribed and sworn to before me this 16th day of November, 1955.

My commission expires March 27 1957 [Signature]
(Notary Public)

(SEAL)

CERTIFICATE OF REGISTRATION

STATE OF OREGON } ss.
County of Marion

This is to certify that the foregoing Registration Statement was received in the office of the State Engineer on the 17th day of November, 1955, at 8:00 o'clock A. M. and has been duly recorded in said office in Book No. 1 of Registration Statements on page 37.

Construction shall be completed by 13, 1956, and the water 13 completely applied to beneficial use by 19.

Witness my hand this 24th day of February, 1956.
Lewis A. Stanley
(State Engineer)

By [Signature]
(Deputy)