Township 34 S. Range 2 W., W.M.

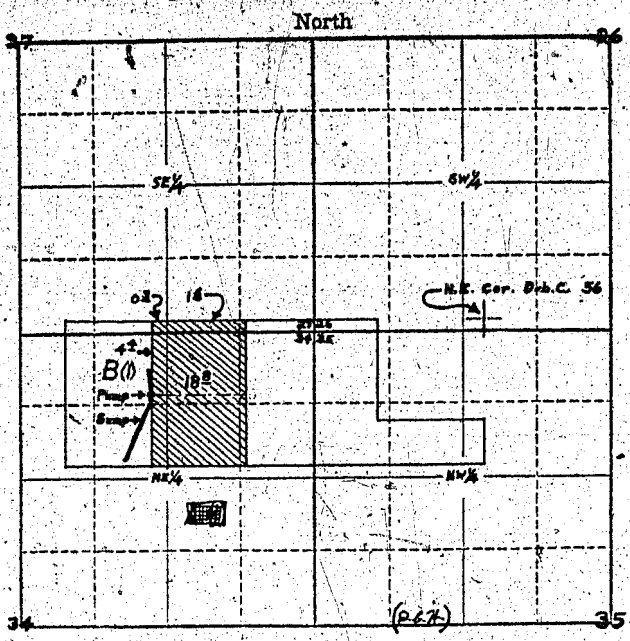

Locate well and acreage of irrigated land on plat.

Scale: 4" = 1 Mile

STATE OF OREGON
County of Jackson } ss:

I, Walter H. Herzog, being first duly sworn, do hereby certify that I have read the foregoing Registration Statement and that all of the items therein contained are true to the best of my knowledge and belief.

Walter H. Herzog
(Signature of Registrant)

Subscribed and sworn to before me this 25th day of March, 1957

My commission expires Nov. 23-1960

Mydal Teel
(Notary Public) for Oregon

(SEAL)

CERTIFICATE OF REGISTRATION

STATE OF OREGON
County of Marion } ss.

This is to certify that the foregoing Registration Statement was received in the office of the State Engineer on the 11th day of April, 1957, at 1:00 o'clock P.M. and has been duly recorded in said office in Book No. 3 of Registration Statements on page GR-424 C

~~Construction shall be completed by X-X-X-X-X-X-X-X-X 19 X-X-X and the water completely applied to beneficial use by X-X-X-X-X-X-X-X-X-X 19 X-X-X~~

Witness my hand this 26th day of June, 1957

Lewis A. Stanley
(State Engineer)

#15.00

By
(Deputy)

GR - 424 C