


Township 11 S Range 3 W W.M.
North

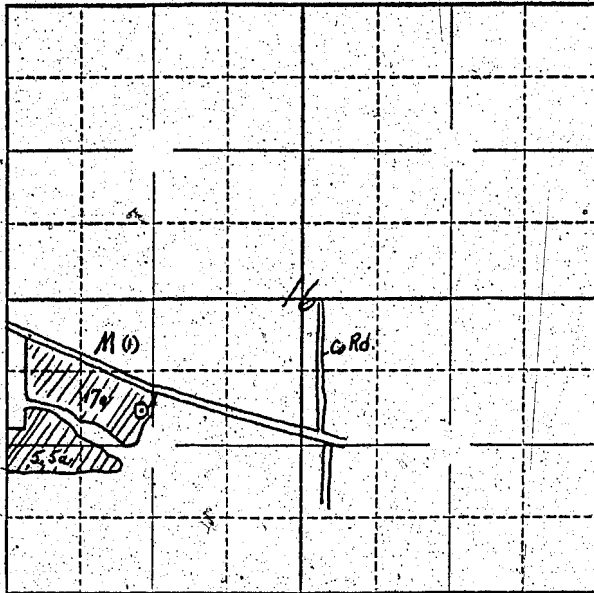

Locate well and acreage of irrigated land on plat.

Scale: $\frac{2''}{4''} = 1 \text{ Mile}$

STATE OF OREGON

County of Linn } ss.

I, Percy Heyerly, being first duly sworn, do hereby certify that I have read the foregoing Registration Statement and that all of the items thereof contained are true to the best of my knowledge and belief.

Percy Heyerly
(Signature of Registrant)

Subscribed and sworn to before me this 17th day of November, 1955

My commission expires _____

R. M. Russell, Clerk
(Notary Public)
Ed. Magart, Deputy

(SEAL)

CERTIFICATE OF REGISTRATION

STATE OF OREGON

County of Marion } ss.

This is to certify that the foregoing Registration Statement was received in the office of the State Engineer on the 18th day of November, 1955, at 8:00 o'clock A.M. and has been duly recorded in said office in Book No. 1 of Registration Statements on page 38

Construction shall ^{is} be completed by _____, 19____, and the water, ^{is} completely applied to beneficial use by _____, 19____

Witness my hand this 24th day of February, 1956

Lewis A. Stanley
(State Engineer)

By _____
(Deputy)