


North

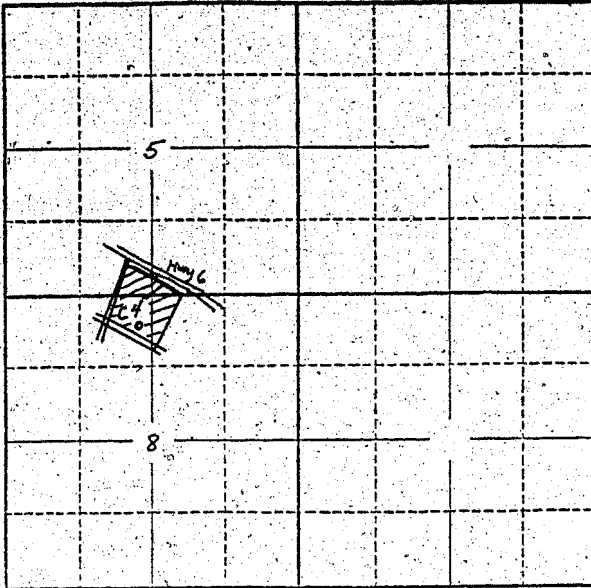

Locate well and acreage of irrigated land on plat.

Scale: 2" = 1 Mile

STATE OF OREGON

County of Wash

} ss.

I, Paul Strehel, being first duly sworn, do hereby certify that I have read the foregoing Registration Statement and that all of the items therein contained are true to the best of my knowledge and belief.

Paul Strehel
(Signature of Registrant)

Subscribed and sworn to before me this 17 day of April, 1957

My commission expires 9-6-58

Wm. E. Hurley
(Notary Public)
WM. E. HURLEY
NOTARY PUBLIC FOR OREGON
My Commission Expires Sept. 6, 1958

(SEAL)

CERTIFICATE OF REGISTRATION

STATE OF OREGON

County of Marion

} ss.

This is to certify that the foregoing Registration Statement was received in the office of the State Engineer on the 15th day of April, 1957, at 8:00 o'clock A. M. and has been duly recorded in said office in Book No. 3 of Registration Statements on page GR-428 C

~~Construction shaker completed by _____ and the water completely applied to beneficial use by _____~~

Witness my hand this 26th day of June, 1957

Lewis J. Stanley
(State Engineer)

By _____ (Deputy)

\$15.00