


North

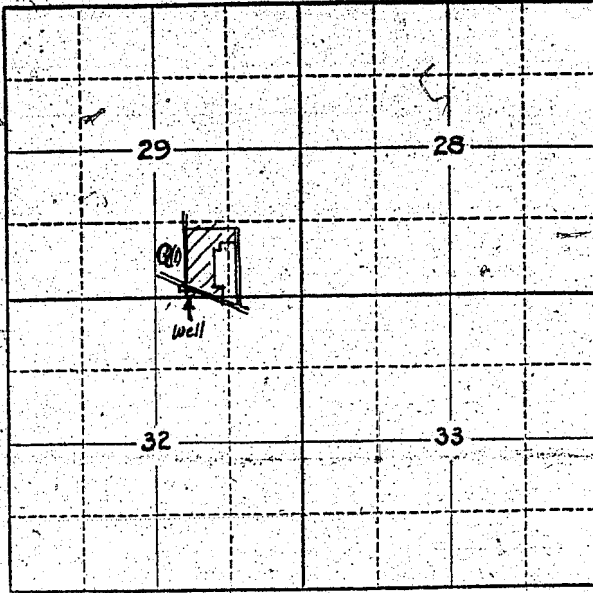

Locate well and acreage of irrigated land on plat.

Scale: 2" = 1 Mile

STATE OF OREGON

County of LANE

} ss.

I, George F. McKibben, being first duly sworn, do hereby certify that I have read the foregoing Registration Statement and that all of the items therein contained are true to the best of my knowledge and belief.

*George F. McKibben*  
(Signature of Registrant)

Subscribed and sworn to before me this 11th day of APRIL, 1957.

My commission expires August 24, 1959 Quentin A. Moore  
(Notary Public for Oregon)

(SEAL)

**CERTIFICATE OF REGISTRATION**

STATE OF OREGON

County of Marion

} ss.

This is to certify that the foregoing Registration Statement was received in the office of the State Engineer on the 15th day of April, 1957, at 1:00 o'clock P.M. and has been duly recorded in said office in Book No. 3 of Registration Statements on page GR-130 C.

~~Construction shall be completed by X-X-X-X-X-X-X-X-X-X-X-X and the water completely applied beneficial use by X-X-X-X-X-X-X-X-X-X-X-X~~

Witness my hand this 26th day of June, 1957.

*Quentin A. Moore*  
(State Engineer)

By \_\_\_\_\_ (Deputy)

# 1500