

Locate well and acreage of irrigated land on plat. Scale: 2" = 1 Mile

STATE OF OREGON }
County of } ss.

I,, being first duly sworn, do hereby certify that I have read the foregoing Registration Statement and that all of the items therein contained are true to the best of my knowledge and belief.

X
(Signature of Registrant)

Subscribed and sworn to before me this day of, 19.....

My commission expires
(Notary Public)

(SEAL)

See Page GR-432 K for
CERTIFICATE OF REGISTRATION

STATE OF OREGON }
County of Marion } ss.


~~This is to certify that the foregoing Registration Statement was received in the office of the State Engineer on the ... day of ... 19... and has been duly recorded in said office in Book No. ... Registration Statement on page ...~~

~~Construction shall be completed by ... and the water completely applied to the benefit of ...~~

Witness my hand this day of, 19.....

.....
(State Engineer)

By
(Deputy)

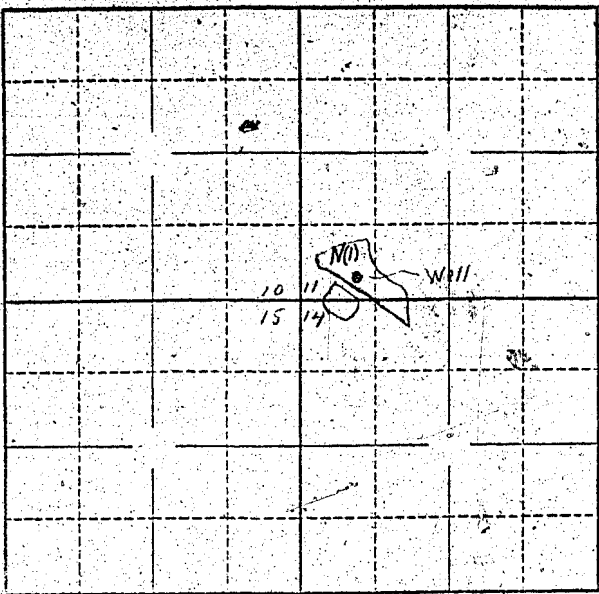

Locate well and acreage of irrigated land on plat.
Scale: 2" = 1 Mile

STATE OF OREGON

County of _____ } ss.

I, _____, being first duly sworn, do hereby certify that I have read the foregoing Registration Statement and that all of the items therein contained are true to the best of my knowledge and belief.

(Signature of Registrant)

Subscribed and sworn to before me this _____ day of _____, 19_____

My commission expires _____
(Notary Public)

(SEAL)

See Page GR-432 K for
CERTIFICATE OF REGISTRATION

STATE OF OREGON

County of Marion } ss.


~~XX This is to certify that the foregoing Registration Statement was received in the office of the State Engineer on the _____ day of _____, 19_____, at _____ and has been duly recorded in said office in Book No. _____ of Registration Statements on page _____.~~
~~Construction shall be completed by _____ and the water complete applied to beneficial use by _____, 19____.~~

Witness my hand this _____ day of _____, 19_____

(State Engineer)

By _____
(Deputy)

Township 10 S Range 4 W W.M. North

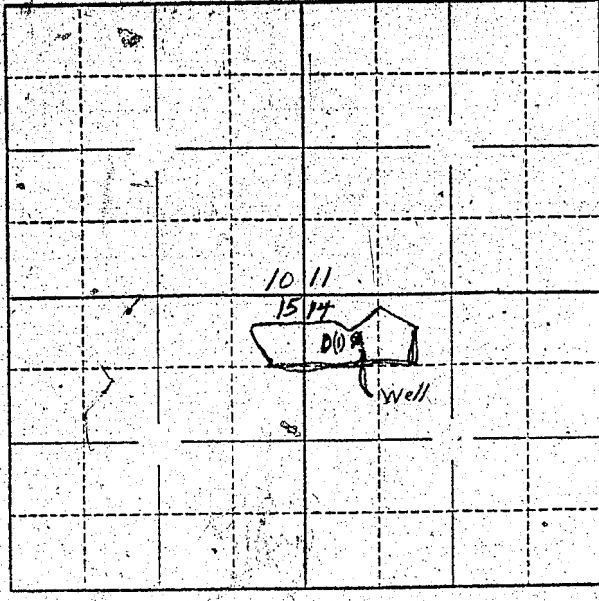

Locate well and acreage of irrigated land on plat.
Scale: 2" = 1 Mile.

STATE OF OREGON

County of Marion ss.

I, Kenneth Holmes, being first duly sworn, do hereby certify that I have read the foregoing Registration Statement and that all of the items therein contained are true to the best of my knowledge and belief.

Kenneth Holmes
(Signature of Registrant)

Subscribed and sworn to before me this 12 day of April, 1957

My commission expires September 8, 1960 Max J. Rogers
(Notary Public)

(SEAL)

CERTIFICATE OF REGISTRATION

STATE OF OREGON

County of Marion ss.

This is to certify that the foregoing Registration Statement was received in the office of the State Engineer on the 18th day of April, 1957, at 10:00 o'clock A. M. and has been duly recorded in said office in Book No. 3 of Registration Statements on page GR-432 K

~~Construction shall be completed by 12-31-59 and the water complex applied to and used by 12-31-60~~

Witness my hand this 26th day of June, 1957

Lewis A. Stanley
(State Engineer)

By _____ (Deputy)

\$ 25.50

GR - 432 K