Township 2 S Range R3E, W.M.

North

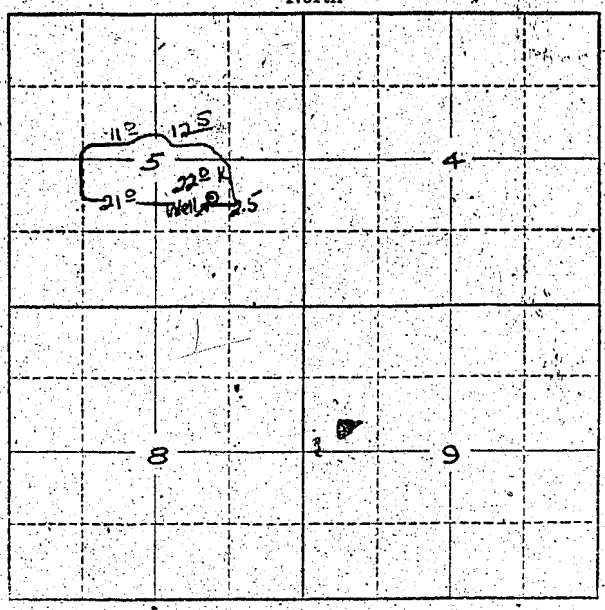

Locate well and acreage of irrigated land on plat.

Scale: 2" = 1 Mile

STATE OF OREGON
County of CLACKAMAS } ss.

I, ERNA BATCHELER, being first duly sworn, do hereby certify that I have read the foregoing Registration Statement and that all of the items therein contained are true to the best of my knowledge and belief.

Erna Batcheler
(Signature of Registrant)

Subscribed and sworn to before me this 12 day of OCTOBER, 19 53

My commission expires 3-9-58

Clifford S. Beckett
(Notary Public) FOR OREGON

(SEAL)

CERTIFICATE OF REGISTRATION

STATE OF OREGON
County of Marion } ss.

This is to certify that the foregoing Registration Statement was received in the office of the State Engineer on the 16th day of April, 19 57, at 1:00 o'clock P. M. and has been duly recorded in said office in Book No. 16 of Registration Statements on page GR-3818

~~xx Construction shall be completed by xxxxxxxxxxxxxxxxxx 19xxx and the water completely applied to beneficial use by xxxxxxxxxxxxxxxxxx 19xx xx~~

Witness my hand this 4th day of December, 19 59

Lewis A. Stanley
(State Engineer)

$20.85

By
(Deputy)

GR-3818