


Township 16 S Range 3 W W.M.  
17 S North 3 W

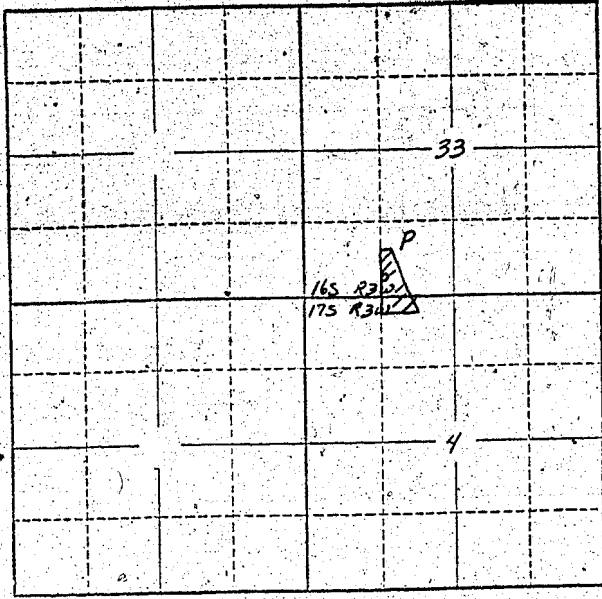

Locate well and acreage of irrigated land on plat.  
Scale: 2" = 1 Mile

STATE OF OREGON }  
County of Linn } ss.

I, Edith Hurd, being first duly sworn, do hereby certify that I have read the foregoing Registration Statement and that all of the items therein contained are true to the best of my knowledge and belief.

*Edith Hurd*  
(Signature of Registrant)

Subscribed and sworn to before me this 20th day of April, 19 57

My commission expires August 13, 1958  
Wm. W. Jones  
(Notary Public) for Oregon

(SEAL)

See Page GR-435 G for  
**CERTIFICATE OF REGISTRATION**

STATE OF OREGON }  
County of Marion } ss.

~~This is to certify that the foregoing Registration Statement was received in the office of the State Engineer on this 19 day of June 19 57 and has been duly recorded in said office in Book No. 19 of Registration Statements on page 57~~


~~Construction shall be completed by 19 and the water completely applied as beneficial use by 19~~

~~Witness my hand this 26th day of June 19 57~~

(State Engineer)

By \_\_\_\_\_  
(Deputy)

Township 16S Range 3W, W.M.  
17S North 3W

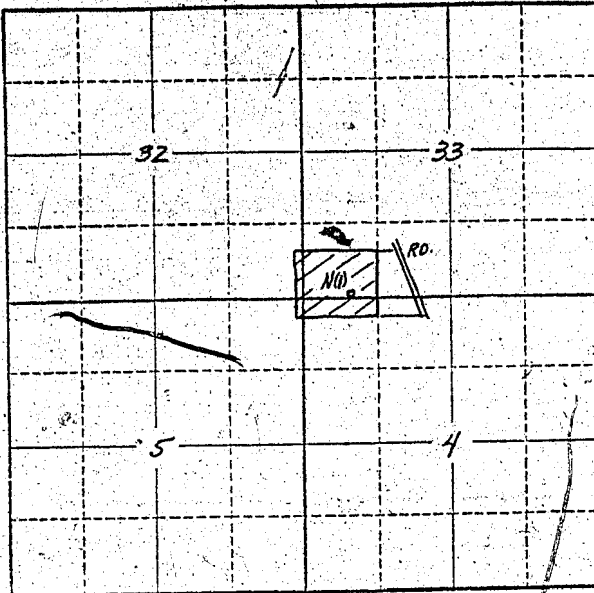

Locate well and acreage of irrigated land on plat.

Scale: 2" = 1 Mile

STATE OF OREGON

County of Linn } ss.

I, Edith Hurd, being first duly sworn, do hereby certify that I have read the foregoing Registration Statement and that all of the items therein contained are true to the best of my knowledge and belief.

*Edith Hurd*

(Signature of Registrant)

Subscribed and sworn to before me this 20th day of April, 1957.

My commission expires August 13, 1958

*Wm. W. ...*

(Notary Public) for Oregon

(SEAL)

**CERTIFICATE OF REGISTRATION**

STATE OF OREGON }  
County of Marion } ss.

This is to certify that the foregoing Registration Statement was received in the office of the State Engineer on the 22nd day of April, 1957, at 8:00 o'clock A. M. and has been duly recorded in said office in Book No. 3 of Registration Statements on page GR-435 G.

~~Construction shall be completed by X-X-X-X-X-X-X-X-X-X-X-X-X-X and the water completely applied to beneficial use by X-X-X-X-X-X-X-X-X-X-X-X-X-X.~~

Witness my hand this 26th day of June, 1957.

*Lewis A. Stanley*

(State Engineer)

By \_\_\_\_\_ (Deputy)