


North

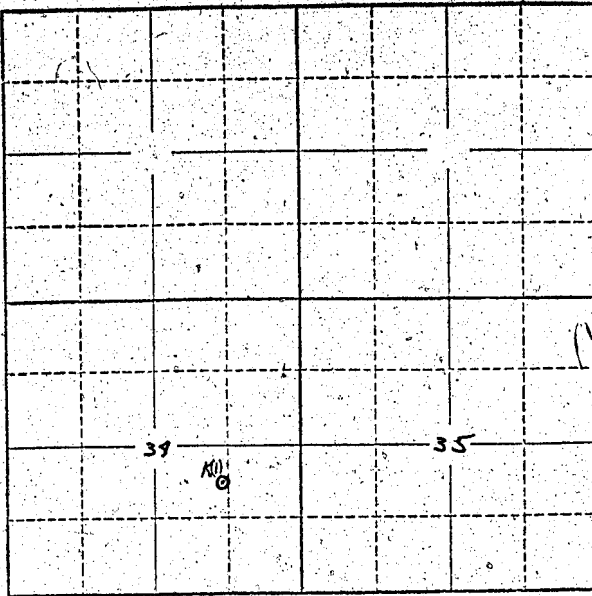

Locate well and acreage of irrigated land on plat.

Scale: 2" = 1 Mile

STATE OF OREGON

County of

} ss.

I,, being first duly sworn, do hereby certify that I have read the foregoing Registration Statement and that all of the items therein contained are true to the best of my knowledge and belief.

Frank V. ...
(Signature of Registrant)

Subscribed and sworn to before me this day of, 19.....

My commission expires

(Notary Public)

(SEAL)

See Page GR-439 0 for
CERTIFICATE OF REGISTRATION

STATE OF OREGON

County of Marion

} ss.

~~This is to certify that the foregoing Registration Statement was received in the office of the State Engineer on the ... day of ... 19... at ... o'clock ... If said has been duly recorded in said office in Book No. ... of Registration Statements on page ...~~


~~Construction shall be completed by ... and the water completed applied to beneficial use by ...~~

~~Witness my hand this 26th day of June 1957~~

(State Engineer)

By
(Deputy)

North

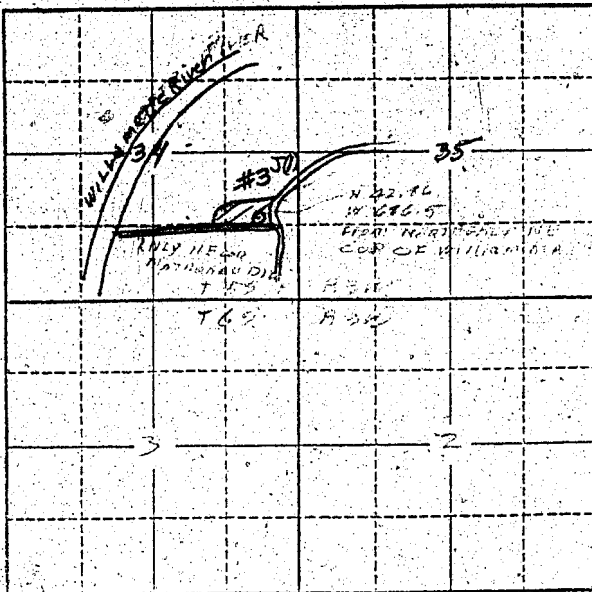

Locate well and acreage of irrigated land on plat.

Scale: 2" = 1 Mile

STATE OF OREGON

County of

} ss.

I, _____, being first duly sworn, do hereby certify that I have read the foregoing Registration Statement and that all of the items therein contained are true to the best of my knowledge and belief.

Frank Wickler
(Signature of Registrant)

Subscribed and sworn to before me this _____ day of _____, 19__

My commission expires

(Notary Public)

(SEAL)

See Page GR-439 O for
CERTIFICATE OF REGISTRATION

STATE OF OREGON

County of Marion

} ss.


~~I do hereby certify that the foregoing Registration Statement was received in the office of the State Engineer on the _____ day of _____, 19__ at _____ o'clock _____ and has been duly recorded in said office in Book _____ of Registration Statements on page _____ Construction shall be completed by _____, 19__, and the water completely applied to beneficial use by _____~~

(State Engineer)

By _____

(Deputy)

North

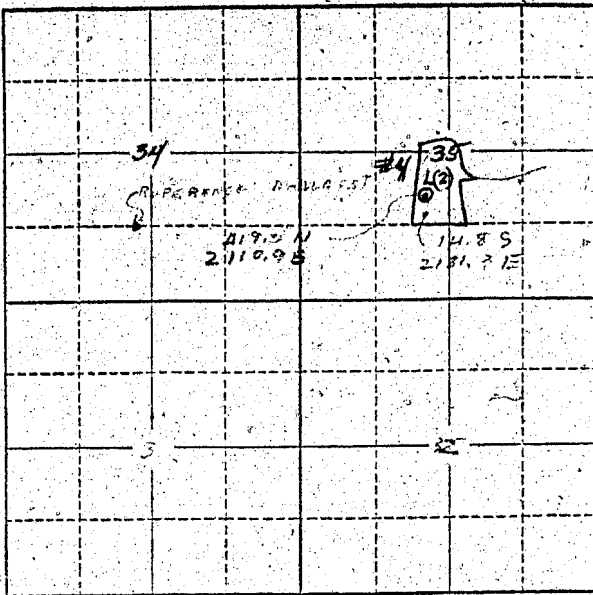

Locate well and acreage of irrigated land on plat.

Scale: 2" = 1 Mile

STATE OF OREGON

County of } ss.

I, being first duly sworn, do hereby certify that I have read the foregoing Registration Statement and that all of the items therein contained are true to the best of my knowledge and belief.

Arvid Visker
(Signature of Registrant)

Subscribed and sworn to before me this day of, 19.....

My commission expires (Notary Public)

(SEAL)

See Page 439 0 for
CERTIFICATE OF REGISTRATION

STATE OF OREGON

County of Marion } ss.

~~XX This is to certify that the foregoing Registration Statement was received in the office of the State Engineer on the X-X-X-X day of X-X-X-X-X-X-X-X, 19X-X, at X-X-X-X-X-X o'clock X-X-X-X and has been duly recorded in said office in Book No. X-X-X-X-X-X of Registration Statements on page X-X-X-X-X-X.~~

~~Construction shall be completed by X-X-X-X-X-X-X-X, 19X-X, and the water completely applied to beneficial use by X-X-X-X-X-X-X-X, 19X-X-XX.~~


Witness my hand this day of, 19.....

..... (State Engineer)

By (Deputy)

Township 55 Range 3W W.M.

North

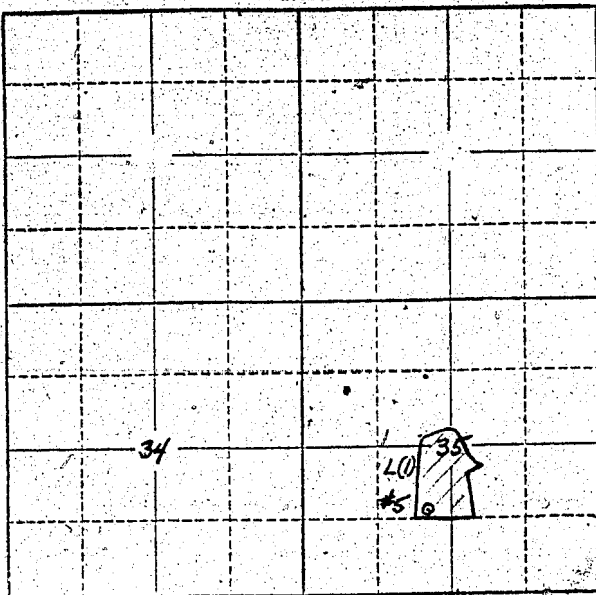

Locate well and acreage of irrigated land on plat.

Scale: 2" = 1 Mile

STATE OF OREGON

County of Marion } ss.

I, Fred Weesker, being first duly sworn, do hereby certify that I have read the foregoing Registration Statement and that all of the items therein contained are true to the best of my knowledge and belief.

Fred Weesker
(Signature of Registrant)

Subscribed and sworn to before me this 22 day of April, 1957

My commission expires March 16, 1958

James C. Hatfield
(Notary Public)

(SEAL)

CERTIFICATE OF REGISTRATION

STATE OF OREGON

County of Marion } ss.

This is to certify that the foregoing Registration Statement was received in the office of the State Engineer on the 22nd day of April, 1957, at 8:00 o'clock A. M. and has been duly recorded in said office in Book No. 3 of Registration Statements on page GR-439 0

~~Construction shall be completed by X-X-X-X-X-X-X-X-X-X and the water completely applied to beneficial use by X-X-X-X-X-X-X-X-X-X~~

Witness my hand this 26th day of June, 1957.

Lewis A. Stanley
(State Engineer)

By _____ (Deputy)

31 25