


North

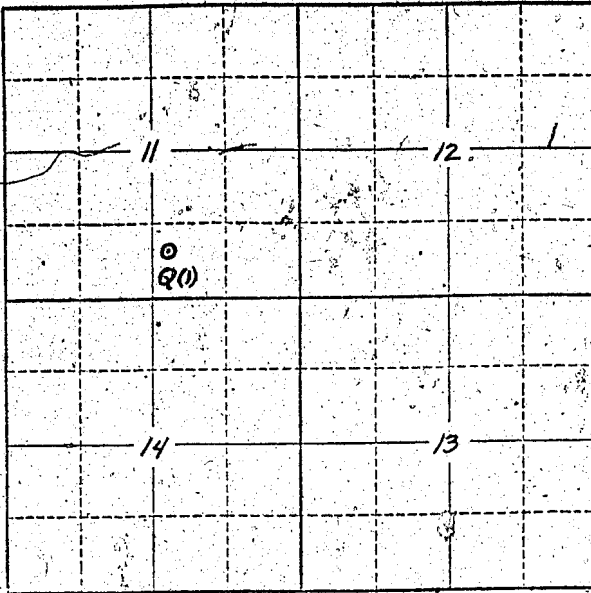

Locate well and acreage of irrigated land on plat.

Scale: 2" = 1 Mile

STATE OF OREGON

County of

ss.

I,, being first duly sworn, do hereby certify that I have read the foregoing Registration Statement and that all of the items therein contained are true to the best of my knowledge and belief.

Frank ...

(Signature of Registrant)

Subscribed and sworn to before me this ... day of ..., 19...

My commission expires

(Notary Public)

(SEAL)

See Page GR-111, 0 for
CERTIFICATE OF REGISTRATION

STATE OF OREGON

County of Marion

ss.

~~This is to certify that the foregoing Registration Statement was received in the office of the State Engineer on the ... day of ... 19... and has been duly recorded in said office on Book No. ... of Registration Statements on page ...~~


~~Construction shall be completed by ... and the water completely applied to beneficial use by ...~~

~~Witness my hand this ... day of ... 19...~~

(State Engineer)

By

(Deputy)

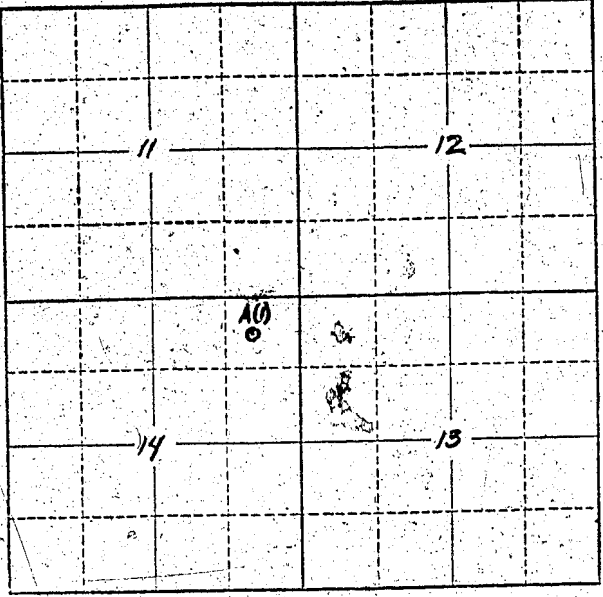

Locate well and acreage of irrigated land on plat.
Scale: 2" = 1 Mile

STATE OF OREGON }
County of _____ } ss.

I, _____, being first duly sworn, do hereby certify that I have read the foregoing Registration Statement and that all of the items therein contained are true to the best of my knowledge and belief.

Frank Winkler
(Signature of Registrant)

Subscribed and sworn to before me this _____ day of _____, 19____

My commission expires _____ (Notary Public)

(SEAL)

See Page GR-444 0 for
CERTIFICATE OF REGISTRATION


STATE OF OREGON }
County of Marion } ss.

~~This is to certify that the foregoing Registration Statement was received in the office of the State Engineer on the _____ day of _____, 19____, and the same has been daily recorded in said office in Book No. _____ of Registration Statements on page _____ Construction shall be completed by _____, 19____, and the water completely applied to beneficial use by _____, 19____.~~

Witness my hand this _____ day of _____, 19____

(State Engineer)

By _____
(Deputy)

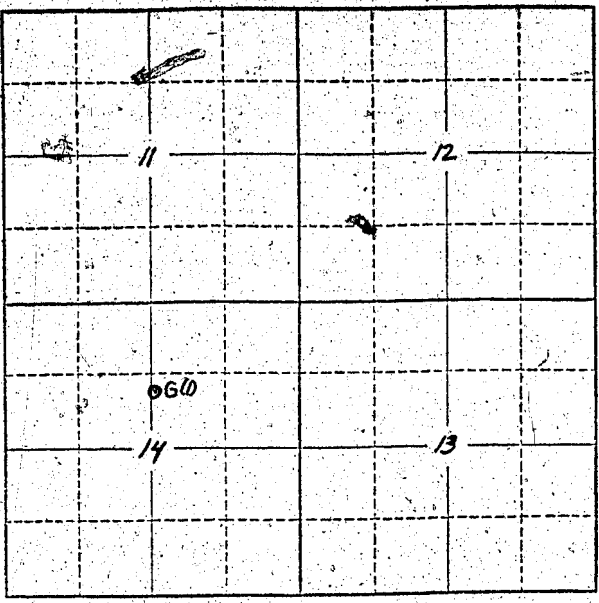

Locate well and acreage of irrigated land on plat.
Scale: 2" = 1 Mile

STATE OF OREGON }
County of _____ } ss.

I, _____, being first duly sworn, do hereby certify that I have read the foregoing Registration Statement and that all of the items therein contained are true to the best of my knowledge and belief.

Fred Clarno
(Signature of Registrant)

Subscribed and sworn to before me this _____ day of _____, 19____.

My commission expires _____ (Notary Public)

(SEAL)

See Page QR-444 0 for
CERTIFICATE OF REGISTRATION


STATE OF OREGON }
County of Marion } ss.

~~XX This is to certify that the foregoing Registration Statement was received in the office of the State Engineer on the X-X-X day of X-X-X-X, 19-X-X, at X-X-X-X o'clock X-X-XM and has been duly recorded in said office in Book No. X-X-X-X of Registration Statements on page X-X-X-X-X. Construction shall be completed by X-X-X-X-X-X, 19-X-X and the water completely applied to beneficial use by X-X-X-X-X-X, 19-X-X-X.~~

Witness my hand this _____ day of _____, 19____.

(State Engineer)

By _____
(Deputy)

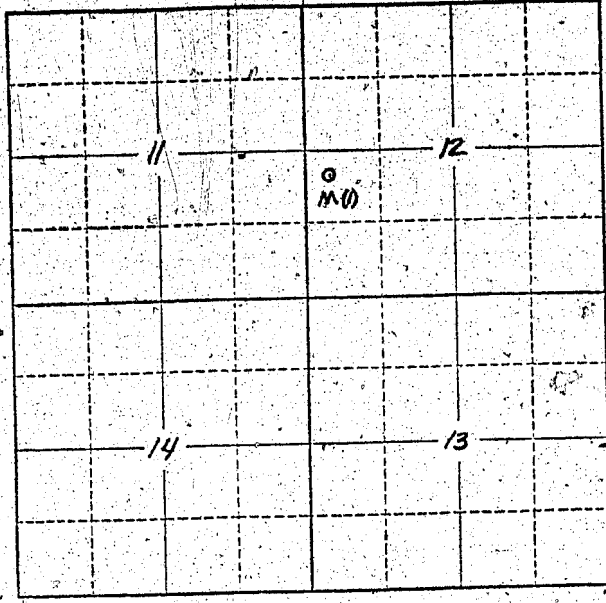

Locate well and acreage of irrigated land on plat.
Scale: 2" = 1 Mile

STATE OF OREGON }
County of Marion } ss.

I, Fred Vespe, being first duly sworn, do hereby certify that I have read the foregoing Registration Statement and that all of the items therein contained are true to the best of my knowledge and belief.

Fred Vespe
(Signature of Registrant)

Subscribed and sworn to before me this 27 day of April, 1957

My commission expires My Commission Expires March 16, 1959

James C. Harfield
(Notary Public)

(SEAL)

CERTIFICATE OF REGISTRATION

STATE OF OREGON }
County of Marion } ss.

This is to certify that the foregoing Registration Statement was received in the office of the State Engineer on the 26th day of April, 1957, at 10:00 o'clock A. M. and has been duly recorded in said office in Book No. 3 of Registration Statements on page GR-444 O

~~Construction shall be completed by x-x-x-x-x-x-x-x-x-x, 19x-x, and the water completed by x-x-x-x-x-x-x-x-x-x beneficial use by x-x-x-x-x-x-x-x-x-x~~

Witness my hand this 26th day of June, 1957

Lewis A. Stanley
(State Engineer)

By _____ (Deputy)

39.85