


North

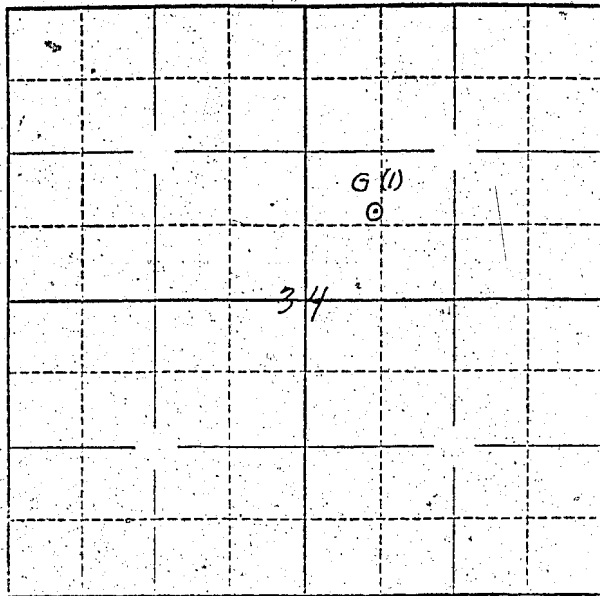

Locate well and acreage of irrigated land on plat.

Scale: 1" = 1 Mile

STATE OF OREGON

County of Jackson } ss.

I, Mrs. Kate S. Nelson being first duly sworn, do hereby certify that I have read the foregoing Registration Statement and that all of the items therein contained are true to the best of my knowledge and belief.

X Kate S. Nelson (Signature of Registrant)

Subscribed and sworn to before me this 29th day of April, 1957.

My commission expires Nov. 23-1960

Hydab. Reid (Notary Public)

(SEAL)

See Page GR-446 K for CERTIFICATE OF REGISTRATION

STATE OF OREGON

County of Marion } ss.


This is to certify that the foregoing Registration Statement was received in the office of the State Engineer on the X-X-X-X day of X-X-X-X, 1957, and has been recorded in said office in Book X-X-X-X of Registration Statements on page X-X-X-X-X.

Registration shall be complete by X-X-X-X-X-X-X-X-X-X and the water exemplar applied for hereafter by X-X-X-X-X-X-X-X-X-X.

(State Engineer)

By (Deputy)

North

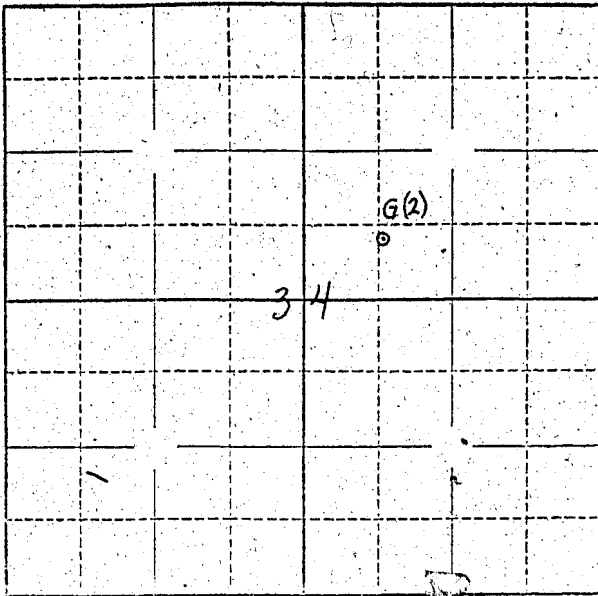

Locate well and acreage of irrigated land on plat.

Scale: 1/4" = 1 Mile
4" = 1 "

STATE OF OREGON

County of Jackson

ss.

I, Mrs. Kate S. Nelson, being first duly sworn, do hereby certify that I have read the foregoing Registration Statement and that all of the items therein contained are true to the best of my knowledge and belief.

X *Kate S. Nelson*
(Signature of Registrant)

Subscribed and sworn to before me this 29th day of April, 1957.

My commission expires Nov. 23 - 1960

Gaydah Reis
(Notary Public)

(SEAL)

See Page GR-416 K for
CERTIFICATE OF REGISTRATION

STATE OF OREGON

County of Marion

ss.

~~I hereby certify that the foregoing Registration Statement was received in the office of the State Engineer and that the same has been recorded in said office in Book No. of Registration Statements on page of said book. Construction of the same shall be made by the State Engineer and the water company of the State Engineer shall be made by the State Engineer.~~

(State Engineer)

By (Deputy)

