

Locate well and acreage of irrigated land on plat.
Scale: 2" = 1 Mile

STATE OF OREGON

County of Lane } ss.

We Elmer Lehman and Ethel M. Lehman being first duly sworn, do hereby certify that we have read the foregoing Registration Statement and that all of the items therein contained are true to the best of my knowledge and belief.

Elmer Lehman

Ethel M. Lehman

(Signature of Registrant)

Subscribed and sworn to before me this 15th day of May 19 57

My commission expires March 14, 1958

Norman H. Bergsund

(Notary Public)

(SEAL)

See Page GR-450 G for
CERTIFICATE OF REGISTRATION

STATE OF OREGON


County of Marion } ss.

This is to certify that the foregoing Registration Statement was received in the office of the State Engineer on the 2nd day of May 19 57 at 8:00 o'clock AM and has been duly recorded in said office in Book No. 3 of Registration Statements on page 50.

Witness my hand this 26th day of June 19 57

(State Engineer)

By _____ (Deputy)

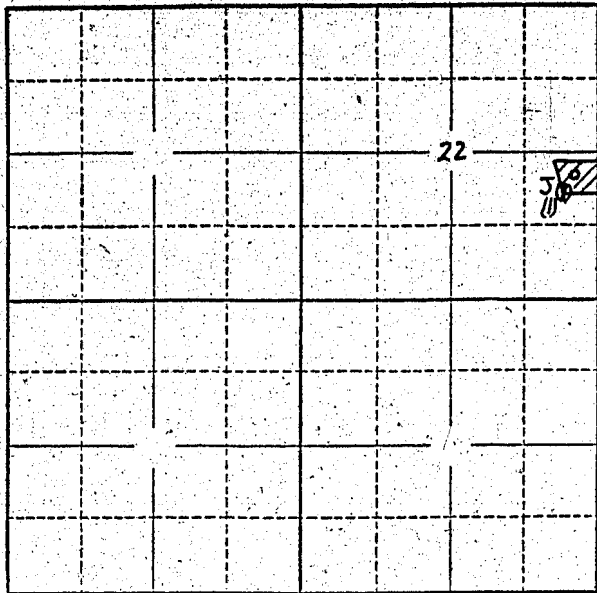

Locate well and acreage of irrigated land on plat.
Scale: 2" = 1 Mile

STATE OF OREGON }
County of Lane } ss.

We Eloise Hedman and Ethel M. Hedman; being first duly sworn, do hereby certify that ^{we} have read the foregoing Registration Statement and that all of the items therein contained are true to the best of my knowledge and belief.
Elmer Hedman
Ethel M Hedman
(Signature of Registrant)

Subscribed and sworn to before me this 1st day of May, 1957.

My commission expires March 14, 1958
Hermon Bergsund
(Notary Public)

(SEAL)

CERTIFICATE OF REGISTRATION

STATE OF OREGON }
County of Marion } ss.

This is to certify that the foregoing Registration Statement was received in the office of the State Engineer on the 2nd day of May, 1957, at 8:00 o'clock A. M. and has been duly recorded in said office in Book No. 3 of Registration Statements on page GR-450 C.

Witness my hand this 26th day of June, 1957.
Lewis A. Stanley
(State Engineer)

By _____
(Deputy)