

Locate well and acreage of irrigated land on plat.
Scale: 2" = 1 Mile

STATE OF OREGON

County of Marion

ss.

I, Alfred Hofman, being first duly sworn, do hereby certify that I have read the foregoing Registration Statement and that all of the items therein contained are true to the best of my knowledge and belief.

Alfred Hofman
(Signature of Registrant)

Subscribed and sworn to before me this 15th day of May, 1957

My commission expires 8/21/58

Patricia A. Beal
(Notary Public)

(SEAL)

See Page GR-453 G for
CERTIFICATE OF REGISTRATION

STATE OF OREGON

County of Marion

ss.



Witness my hand this 15th day of May, 1957

(State Engineer)

By

(Deputy)

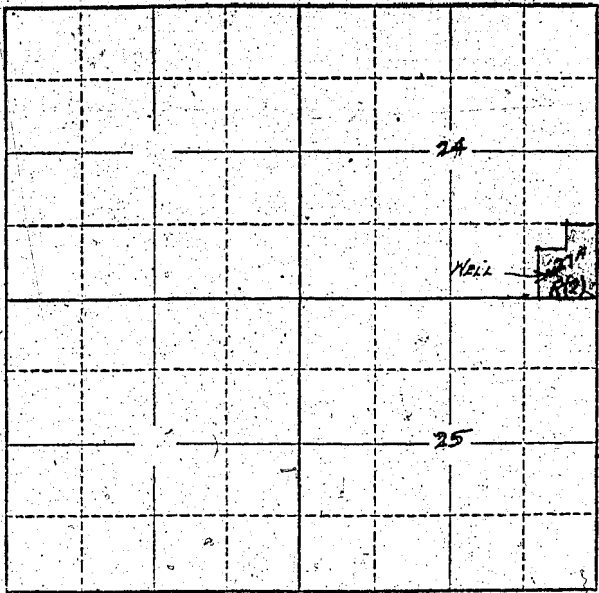

Locate well and acreage of irrigated land on plat.
Scale: 2" = 1 Mile

STATE OF OREGON

County of Marion } ss.

I, Alfred Hofman, being first duly sworn, do hereby certify that I have read the foregoing Registration Statement and that all of the items therein contained are true to the best of my knowledge and belief.

Alfred Hofman
(Signature of Registrant)

Subscribed and sworn to before me this 1st day of May, 1957

My commission expires 8/2/58

Notary Public
(Notary Public)

(SEAL)

CERTIFICATE OF REGISTRATION

STATE OF OREGON }
County of Marion } ss.

This is to certify that the foregoing Registration Statement was received in the office of the State Engineer on the 3rd day of May, 1957, at 8:00 o'clock A. M. and has been duly recorded in said office in Book No. 3 of Registration Statements on page GR-453 C.

~~Construction shall be completed by x-x-x-x-x-x-x-x-x-x-x-x-x-x-x-x and the water completely applied to beneficial use by x-x-x-x-x-x-x-x-x-x-x-x-x-x-x-x 19-x-x-x-x~~

Witness my hand this 26th day of June, 19 57

Lewis A. Stanley
(State Engineer)

By _____ (Deputy)