



Groundwater Registration Modification - GR 472 - Avellana Farms LLC

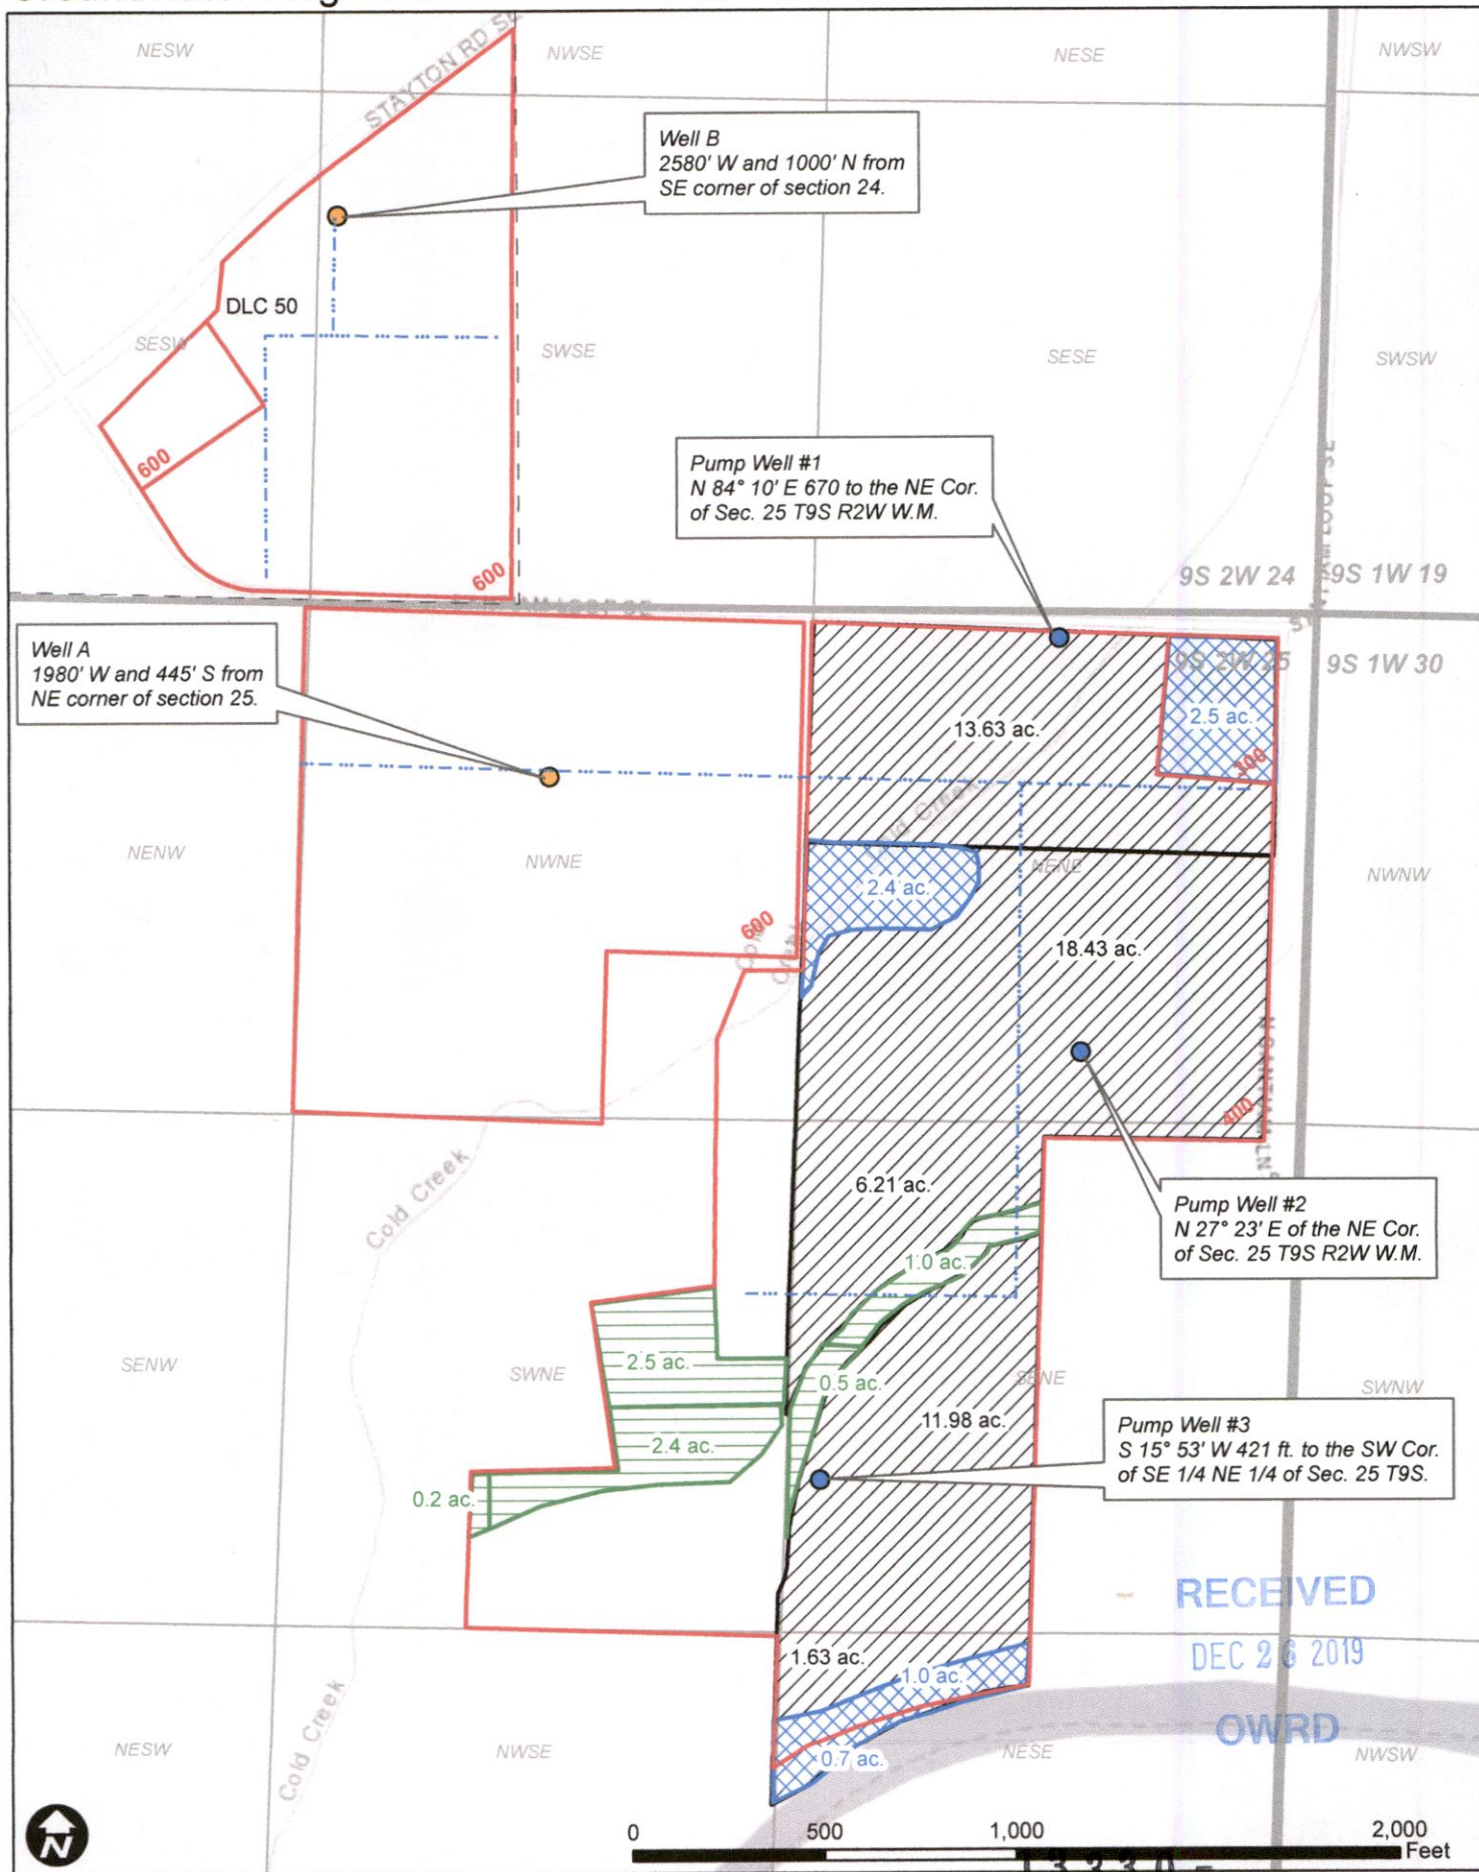

GR 472 FROM
 GR 472 TO
 DLC
 Mainline

WILL MCGILL SURVEYING, LLC
 15333 Pletzer Rd. SE, Turner, OR 97392
 503-510-3026, willmcgill.surveying@gmail.com

North

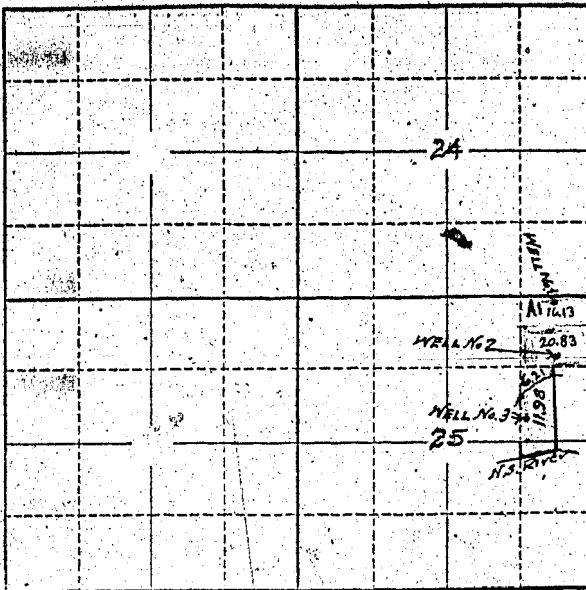

Locate well and acreage of irrigated land on plat.

Scale: 2" = 1 Mile

STATE OF OREGON

County of Marion } ss.

Edo Nelson, being first duly sworn, do hereby certify that I have read the foregoing Registration Statement and that all of the items therein contained are true to the best of my knowledge and belief.

Edo Nelson
(Signature of Registrant)

Subscribed and sworn to before me this 1st day of May, 1927.

My commission expires 3/21/28 Nathan H. Beck
(Notary Public)

(SEAL)

See Page GR-454 K for
CERTIFICATE OF REGISTRATION

STATE OF OREGON

County of Marion } ss.


~~This is to certify that the foregoing Registration Statement was received in the office of the State Engineer on the x-x-x-x day of x-x-x-x, 19-x-x, and has been duly recorded in said office in Book No. x-x-x-x of Registration Statements on page x-x-x-x.~~

~~Construction shall be completed by x-x-x-x, and the water completely applied to beneficial use by x-x-x-x.~~

Witness my hand this _____ day of _____, 19____.

(State Engineer)

By _____
(Deputy)

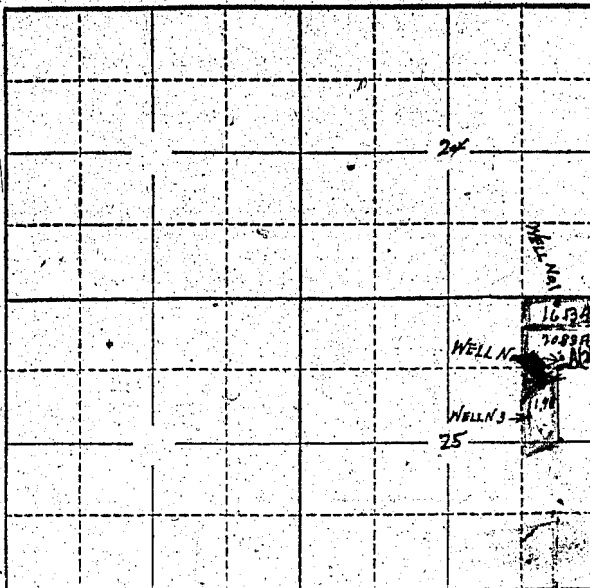

Locate well and acreage of irrigated land on plat.

Scale: 2" = 1 Mile

STATE OF OREGON

County of Marion } ss.

I, Otto Nelson, being first duly sworn, do hereby certify that I have read the foregoing Registration Statement and that all of the items therein contained are true to the best of my knowledge and belief.

Otto Nelson
(Signature of Registrant)

Subscribed and sworn to before me this 1st day of May, 1957

My commission expires 8/21/58

Walter H. Beall
(Notary Public)

(SEAL)

See Page GR-451, K for
CERTIFICATE OF REGISTRATION

STATE OF OREGON

County of Marion } ss.

~~This is to certify that the foregoing Registration Statement was received in the office of the State Engineer on the x-x-x day of x-x-x-x-x-x-x-x-x-x 19-x-x at x-x-x-x-x-x-x-x-x-x and has been duly received in said office in Book No. x-x-x-x-x of Registration Statements on page x-x-x-x-x. Construction shall be completed by x-x-x-x-x-x-x-x-x-x 19-x-x and the water completely applied to beneficial use by x-x-x-x-x-x-x-x-x-x 19-x-x.~~

Witness my hand this day of, 19.....

(State Engineer)

By
(Deputy)

