Township 9S Range 2W, W.M.

North

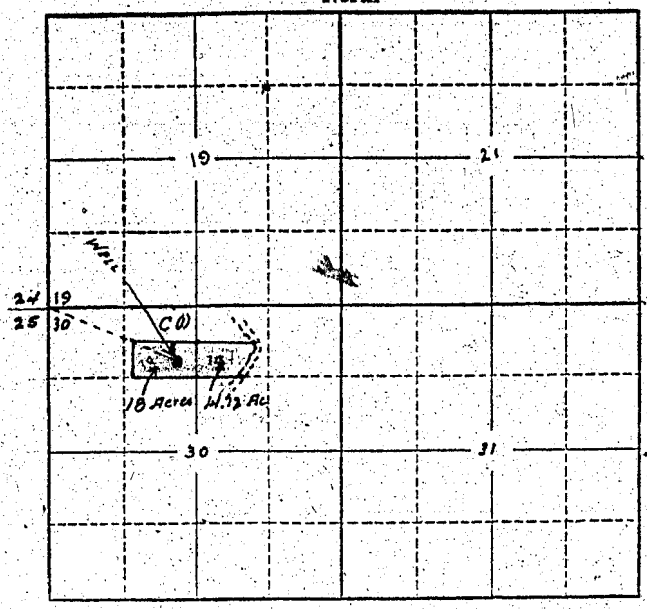

Locate well and acreage of irrigated land on plat.

Scale: 2" = 1 Mile

STATE OF OREGON
County of Marion } ss.

I, Lawrence T Kilmer, being first duly sworn, do hereby certify that I have read the foregoing Registration Statement and that all of the items therein contained are true to the best of my knowledge and belief.

Lawrence T Kilmer
(Signature of Registrant)

Subscribed and sworn to before me this 1st day of May, 19 57.

My commission expires 12-21-59

(Notary Public)

(SEAL)

CERTIFICATE OF REGISTRATION

STATE OF OREGON
County of Marion } ss.

This is to certify that the foregoing Registration Statement was received in the office of the State Engineer on the 3rd day of May, 19 57, at 8:00 o'clock A. M. and has been duly recorded in said office in Book No. 3 of Registration Statements on page GR-455 C.

~~Construction shall be completed by ... 19 ... and the water completely applied for beneficial use by ... 19 ...~~

Witness my hand this 26th day of June, 19 57

Lewis A. Stanley
(State Engineer)

By ..... (Deputy)

GR - 455 C