


North

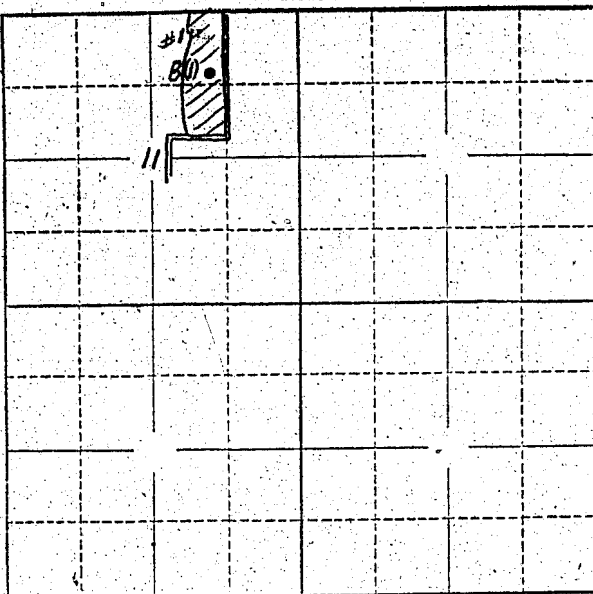

Locate well and acreage of irrigated land on plat.

Scale: 2" = 1 Mile

STATE OF OREGON

County of Linn } ss.

I, Charles W. and Patricia Chambers, being first duly sworn, do hereby certify that I have read the foregoing Registration Statement and that all of the items therein contained are true to the best of my knowledge and belief.

Charles W. Chambers, Patricia Chambers (Signature of Registrant)

Subscribed and sworn to before me this 25th day of April, 1957.

My commission expires May 11, 1960.

Raymond B. Mackie (Notary Public for Oregon)

(SEAL)

See Page GR-457 G for CERTIFICATE OF REGISTRATION

STATE OF OREGON } ss. County of Marion


This is to certify that the foregoing Registration Statement was received in the office of the State Engineer on the 25th day of April, 1957, at 10 o'clock A.M. and has been duly recorded in said office in Book No. of Registration Statements on page Construction shall be completed by 1958 and the water completely applied to beneficial use by 1958.

Witness my hand this day of 1957.

(State Engineer)

By (Deputy)

North

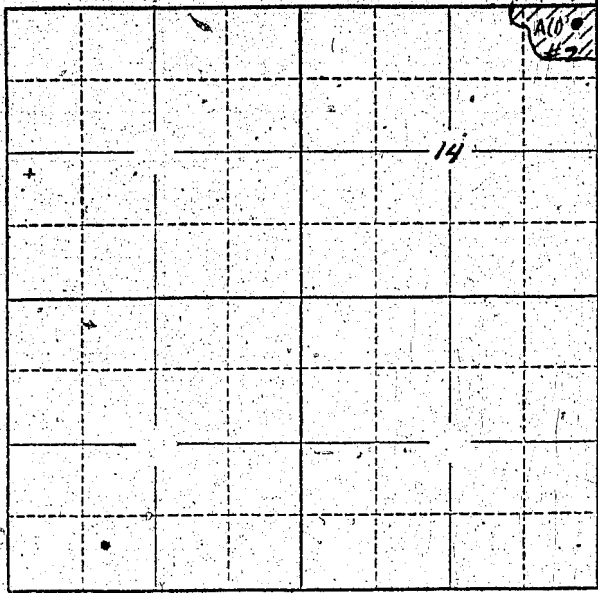

Locate well and acreage of irrigated land on plat.

Scale: 2" = 1 Mile

STATE OF OREGON

County of LINN } ss.

I, CHARLES W. CHAMBERS
and PATRICIA CHAMBERS being first duly sworn, do hereby certify that I have read the foregoing Registration Statement and that all of the items therein contained are true to the best of my knowledge and belief.

Charles W. Chambers Patricia Chambers
(Signature of Registrant)

Subscribed and sworn to before me this 25th day of April 1957

My commission expires MAY 11, 1960

Raymond S. Markes
(Notary Public) For Oregon

(SEAL)

CERTIFICATE OF REGISTRATION

STATE OF OREGON } ss.
County of Marion

This is to certify that the foregoing Registration Statement was received in the office of the State Engineer on the 6th day of May, 1957 at 8:00 o'clock A. M. and has been duly recorded in said office in Book No. 3 of Registration Statements on page GR-457 G

~~Construction shall be completed by XXXXXX, XXXXXX and the water completely applied to beneficial use by XXXXXX~~

Witness my hand this 26th day of June 1957

Stuart A. Stanley
(State Engineer)

\$23.85

By _____ (Deputy)