Township 11 S Range 2 W., W.M.

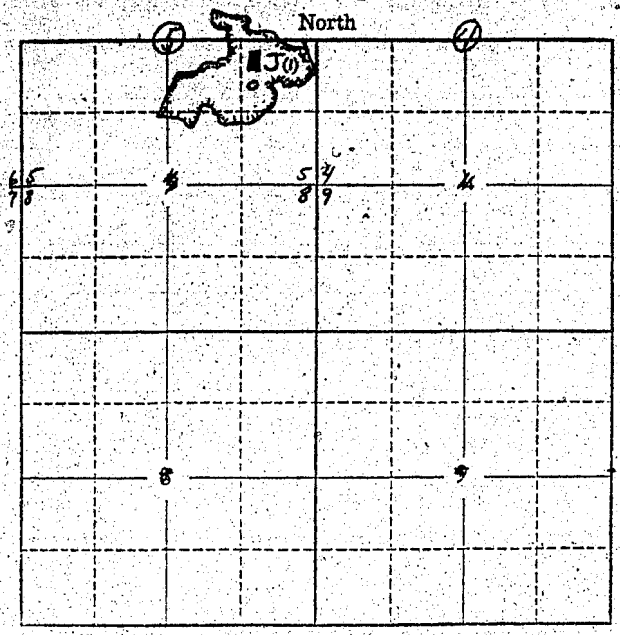

Locate well and acreage of irrigated land on plat.

Scale: 2" = 1 Mile

STATE OF OREGON
County of Linn } ss.

I, Bose Brothers, being first duly sworn, do hereby certify that I have read the foregoing Registration Statement and that all of the items therein contained are true to the best of my knowledge and belief.

Bose Bros.
By Harry Bose
(Signature of Registrant)

Subscribed and sworn to before me this 2nd day of May, 1957

My commission expires October 30, 1960 Mary E. Fontana
(Notary Public)

(SEAL)

CERTIFICATE OF REGISTRATION

STATE OF OREGON
County of Marion } ss.

This is to certify that the foregoing Registration Statement was received in the office of the State Engineer on the 6th day of May, 1957, at 8:00 o'clock A. M. and has been duly recorded in said office in Book No. 3 of Registration Statements on page GR-458 C.

~~Construction shall be completed by X-X-X-X-X-X-X-X-X-X-12-X-X and the water compact applied to beneficial use by X-X-X-X-X-X-X-X-X-X-19X-X-X~~

Witness my hand this 26th day of June, 1957

Lewis A. Stanley
(State Engineer)

By
(Deputy)

$20.55

GR - 458 C