

Locate well and acreage of irrigated land on plat.
Scale: 2" = 1 Mile

STATE OF OREGON

County of Washington } ss.

I, Louis Malinsky, being first duly sworn, do hereby certify that I have read the foregoing Registration Statement and that all of the items therein contained are true to the best of my knowledge and belief.

Louis Malinsky
(Signature of Registrant)

Subscribed and sworn to before me this 2nd day of May, 1957.

My commission expires Dec 7-1959 Highpoint
(Notary Public)

(SEAL)

See Page GR-460 0 for
CERTIFICATE OF REGISTRATION

STATE OF OREGON

County of Marion } ss.


~~This is to certify that the foregoing Registration Statement was received in the office of the State Engineer on the day of 19 o'clock and has been duly recorded in said office in Book No. of Registration Statements on page~~

~~Construction shall be completed by and the water completely applied to beneficial use by~~

~~Witness my hand this day of 19~~

(State Engineer)

By _____
(Deputy)

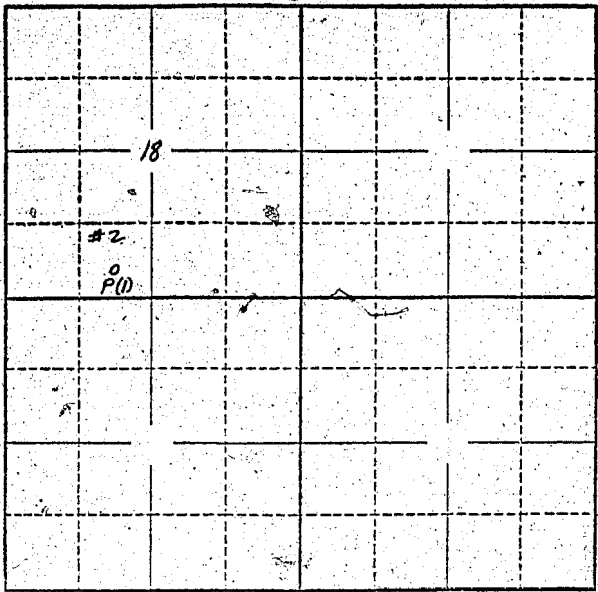

Locate well and acreage of irrigated land on plat.
Scale: 2" = 1 Mile

STATE OF OREGON

County of Washington } ss.

I, Louis Malinsky, being first duly sworn, do hereby certify that I have read the foregoing Registration Statement and that all of the items therein contained are true to the best of my knowledge and belief.

Louis Malinsky
(Signature of Registrant)

Subscribed and sworn to before me this 2nd day of May, 1957

My commission expires Dec 7-1959

Dydeljunt
(Notary Public)

(SEAL)

See Page GR-460 0 for
CERTIFICATE OF REGISTRATION

STATE OF OREGON

County of Marion } ss.

~~This is to certify that the foregoing Registration Statement was received in the office of the State Engineer on the x-x-x-x day of x-x-x-x 19-x-x at x-x-x-x o'clock x-x-x-x and has been duly recorded in said office in Book No. x-x-x-x-x-x Registration Statement on page x-x-x-x-x-x~~


~~Construction shall be completed by x-x-x-x-x-x-19-x-x and the water completely applied to x-x-x-x-x-x-x-x-x-x-19-x-x~~

Witness my hand this _____ day of _____, 19____

(State Engineer)

By _____
(Deputy)

North

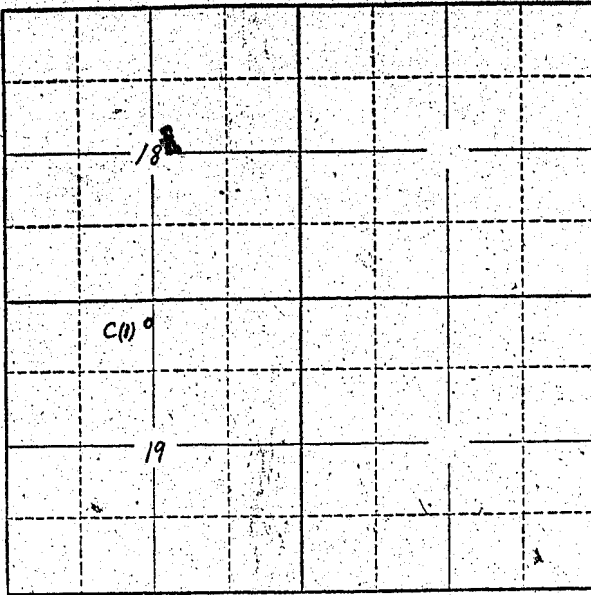

Locate well and acreage of irrigated land on plat.

Scale: 2" = 1 Mile

STATE OF OREGON

County of Washington } ss.

I, Louis R. Malinsky, being first duly sworn, do hereby certify that I have read the foregoing Registration Statement and that all of the items therein contained are true to the best of my knowledge and belief.

Louis R. Malinsky
(Signature of Registrant)

Subscribed and sworn to before me this 2nd day of May, 1957.

My commission expires Dec 7-1959
Claydelmont
(Notary Public)

(SEAL)

See Page GR-460.0 for
CERTIFICATE OF REGISTRATION

STATE OF OREGON

County of Marion } ss.

~~This is to certify that the foregoing Registration Statement was received in the office of the State Engineer on the x-x-x day of x-x-x-x-x-x-x-x, 19-x-x at x-x-x-x-x o'clock x-x-x and has been duly recorded in said office in Book No. x-x-x-x of Registration Statements on page x-x-x-x-x~~

~~Construction shall be completed by x-x-x-x-x-x-x-x-12-x-x and the water completely applied to beneficiaries by x-x-x-x-x-x-x-x-12-x-x.~~

Witness my hand this _____ day of _____, 19_____.

(State Engineer)

By _____
(Deputy)

