


Township 11S Range 3W, W.M.  
North

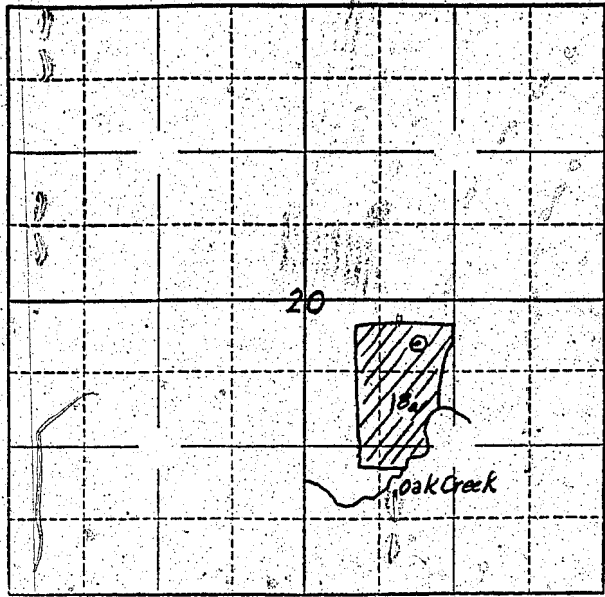

Locate well and acreage of irrigated land on plat.  
Scale:  $\frac{1}{4}$ " = 1 Mile

STATE OF OREGON  
County of Linn

ss.

I, Oliver and Sarah Schmucker, being first duly sworn, do hereby certify that I have read the foregoing Registration Statement and that all of the items therein contained are true to the best of my knowledge and belief.

Oliver Schmucker

Sarah Schmucker  
(Signature of Registrant)

Subscribed and sworn to before me this 18<sup>th</sup> day of November, 1955

My commission expires Aug 4, 1957

Saronales Street  
(Notary Public)

(SEAL)

**CERTIFICATE OF REGISTRATION**

STATE OF OREGON }  
County of Marion } ss.

This is to certify that the foregoing Registration Statement was received in the office of the State Engineer on the 21<sup>st</sup> day of November, 1955, at 8:00 o'clock A. M. and has been duly recorded in said office in Book No. 1 of Registration Statements on page 41

Construction shall be completed by \_\_\_\_\_, 19\_\_\_\_, and the water <sup>is</sup> completely applied to beneficial use by \_\_\_\_\_, 19\_\_\_\_.

Witness my hand this 24<sup>th</sup> day of February, 1956.

Lewis A. Stanley  
(State Engineer)

By \_\_\_\_\_  
(Deputy)