


Township 9 Range 11 W, W.M.
North

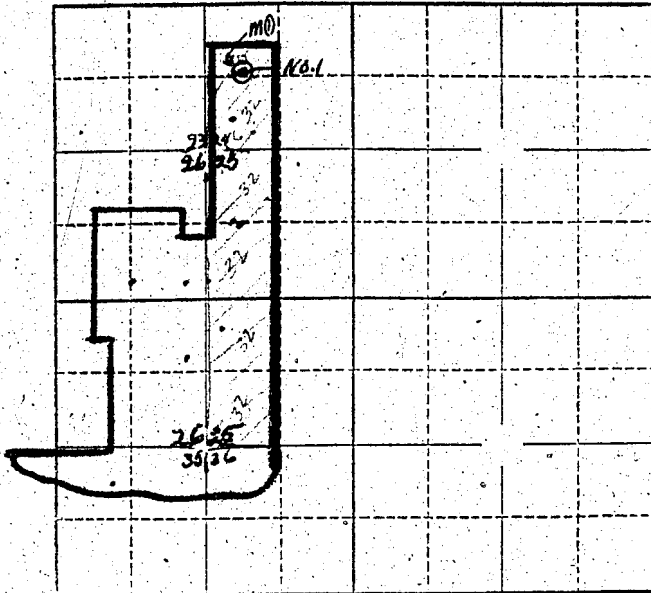

Locate well and acreage of irrigated land on plat.
Scale: 2" = 1 Mile

STATE OF OREGON }
County of } ss.

I,, being first duly sworn, do hereby certify that I have read the foregoing Registration Statement and that all of the items therein contained are true to the best of my knowledge and belief.

.....
(Signature of Registrant)

Subscribed and sworn to before me this day of, 19.....

My commission expires
(Notary Public)

(SEAL)

See Page GR-467 Z-17 for
CERTIFICATE OF REGISTRATION

STATE OF OREGON }
County of Marion } ss.

~~This is to certify that the foregoing Registration Statement was received in the office of the State Engineer on the X-X-X day of X-X-X-X-X-X-X-X, 19X-X, at X-X-X-X-X-X o'clock X-X-X of X-X-X-X and has been duly recorded in said office in Book No. X-X-X-X-X-X Registration Statement on page X-X-X-X-X-X~~


~~Construction shall be completed by X-X-X-X-X-X-X-X and the state completely applied to beneficial use by X-X-X-X-X-X-X-X 19-X-X~~

~~Witness my hand this X-24th day of X-X-X-X-X-X, 19-X-X~~

.....
(State Engineer)

By
(Deputy)

Township 9 S Range 4 W, W.M.
North

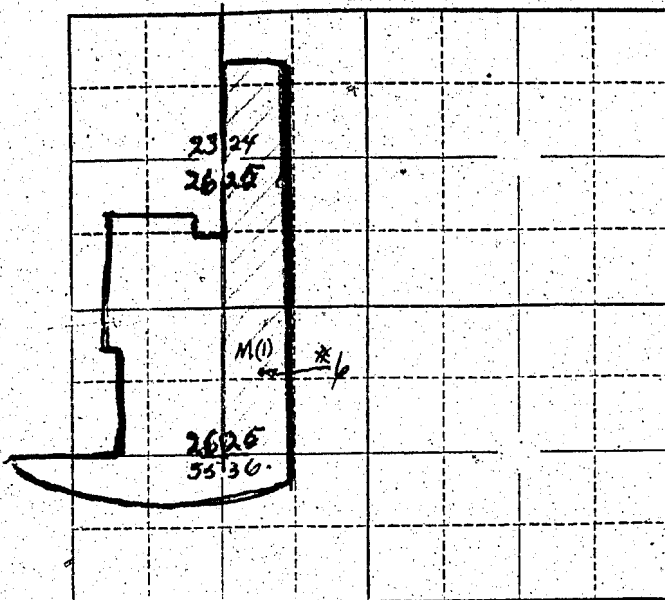

Locate well and acreage of irrigated land on plat.
Scale: 2" = 1 Mile

STATE OF OREGON

County of _____ } ss.

I, _____, being first duly sworn, do hereby certify that I have read the foregoing Registration Statement and that all of the items therein contained are true to the best of my knowledge and belief.

(Signature of Registrant)

Subscribed and sworn to before me this _____ day of _____, 19____.

My commission expires _____

(Notary Public)

(SEAL)

See Page GR-467 Z-17 for
CERTIFICATE OF REGISTRATION

STATE OF OREGON


County of Marion } ss.

~~I hereby certify that the foregoing Registration Statement was received in the office of the State Engineer on the _____ day of _____ 19____ at _____ o'clock _____ and has been duly recorded in said office Book No. _____ of Registration Statements on page _____~~
~~Construction shall be completed by _____ 19____ and the water completely applied to beneficial use by _____ 19____~~

(State Engineer)

By _____
(Deputy)

Township 9S Range 4W, W.M.
North

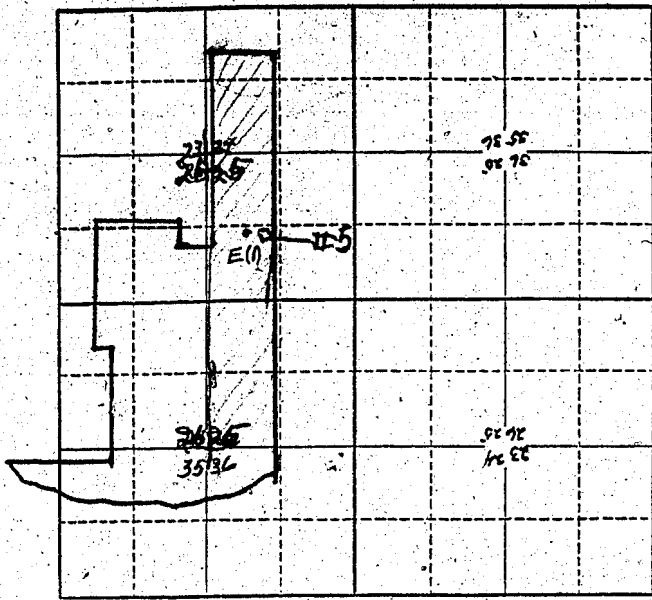

Locate well and acreage of irrigated land on plat.
Scale: 2" = 1 Mile

STATE OF OREGON }
County of _____ } ss.

I, _____, being first duly sworn, do hereby certify that I have read the foregoing Registration Statement and that all of the items therein contained are true to the best of my knowledge and belief.

(Signature of Registrant)

Subscribed and sworn to before me this _____ day of _____, 19____

My commission expires _____
(Notary Public)

(SEAL)

See Page GR-467 Z-17 for
CERTIFICATE OF REGISTRATION

STATE OF OREGON }
County of Marion } ss.


~~XY I do not certify that the foregoing Registration Statement was received in the office of the State Engineer on the _____ day of _____, 19____, at _____, Oregon, and has been duly recorded in said office in Book No. _____ of Registration Statements on page _____.~~

~~Witness my hand this _____ day of _____, 19____~~

(State Engineer)

By _____
(Deputy)

Township 9S Range 4W W.M.
North

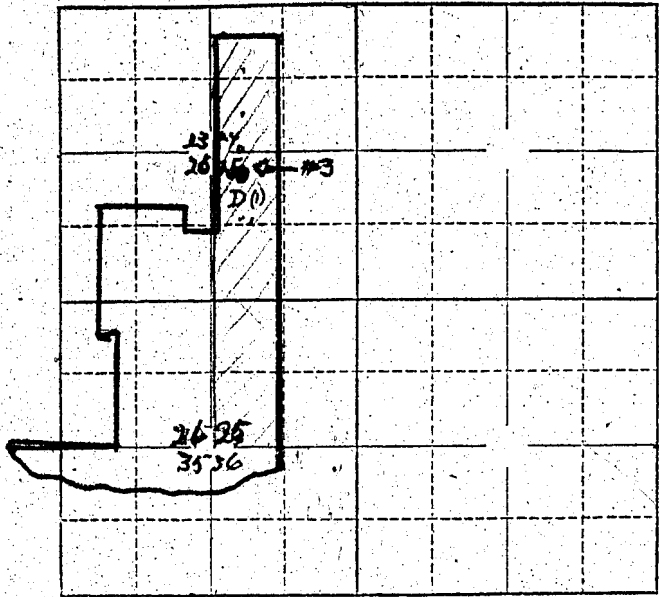

Locate well and acreage of irrigated land on plat.
Scale: 2" = 1 Mile

STATE OF OREGON

County of _____ } ss.

I, _____, being first duly sworn, do hereby certify that I have read the foregoing Registration Statement and that all of the items therein contained are true to the best of my knowledge and belief.

(Signature of Registrant)

Subscribed and sworn to before me this _____ day of _____, 19____.

My commission expires _____ (Notary Public)

(SEAL)

See Page GR-467 Z-17
CERTIFICATE OF REGISTRATION

STATE OF OREGON


County of Marion } ss.

~~This is to certify that the foregoing Registration Statement was received in the office of the State Engineer on the _____ day of _____ 19____ and has been duly recorded in said office in Book No. _____ of Registration Statements on page _____ Construction work by _____ and the water completely applied to beneficial use by _____~~

(State Engineer)

By _____ (Deputy)

Township T. 9. S. Range 14 W. W.M.
North

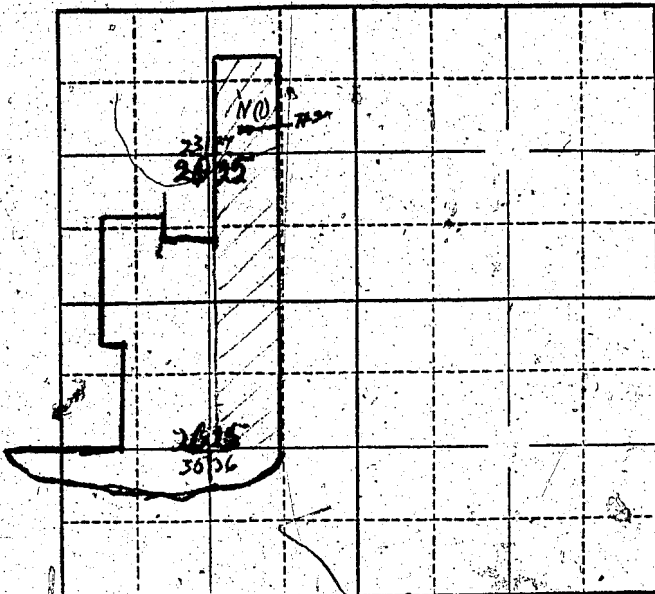

Locate well and acreage of irrigated land on plat.

Scale: 2" = 1 Mile

STATE OF OREGON,

County of

} ss.

I,, being first duly sworn, do hereby certify that I have read the foregoing Registration Statement and that all of the items therein contained are true to the best of my knowledge and belief.

.....
(Signature of Registrant)

Subscribed and sworn to before me this day of, 19.....

My commission expires

.....
(Notary Public)

(SEAL)

See Page GR-467 Z-17

CERTIFICATE OF REGISTRATION

STATE OF OREGON

County of Marion >

} ss.

This is to certify that the foregoing Registration Statement was received in the office of the State Engineer on the day of 19..... and has been duly recorded in said office in Book No. of Registration Statements on page X

Witness my hand this day of 19.....


.....
(State Engineer)

By

.....
(Deputy)

GR - 467 W

Township 9 S. Range 11 W., W.M.
North

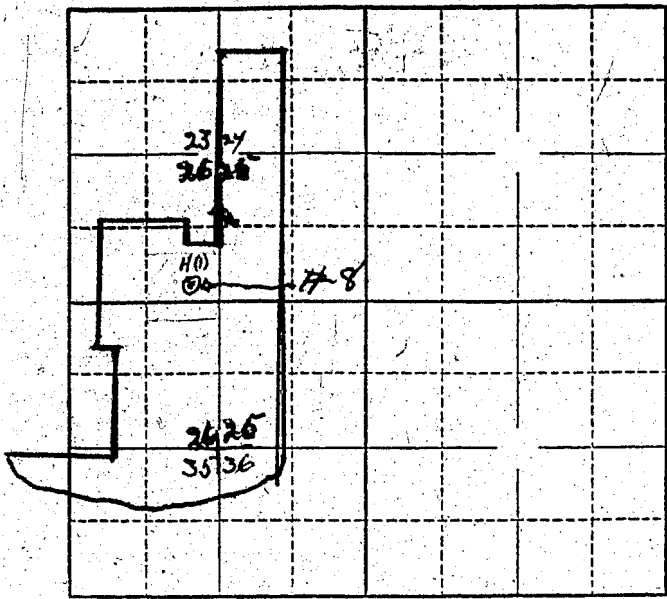

Locate well and acreage of irrigated land on plat.
Scale: 2" = 1 Mile

STATE OF OREGON }
County of } ss.

I,, being first duly sworn, do hereby certify that I have read the foregoing Registration Statement and that all of the items therein contained are true to the best of my knowledge and belief.

.....
(Signature of Registrant)

Subscribed and sworn to before me this day of, 19.....

My commission expires
(Notary Public)

(SEAL)

See Page GR-467 Z-17 for
CERTIFICATE OF REGISTRATION

STATE OF OREGON }
County of Marion } ss.

~~This is to certify that the foregoing Registration Statement was received in the office of the State Engineer on the X-X-X-X day of X-X-X-X, 19-X-X at X-X-X-X O'clock X-X-X-M and has been duly recorded in said office in Book No. X-X-X-X of Registration Statements on page X-X-X-X-X~~


~~Witness my hand this X-X-X-X day of X-X-X-X, 19-X-X-X~~

.....
(State Engineer)

By
(Deputy)

Township 9S Range 14W, W.M.

North

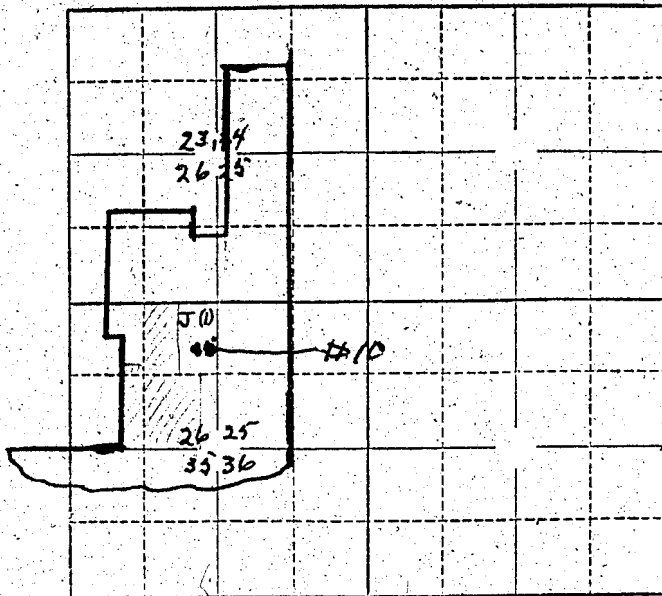

Locate well and acreage of irrigated land on plat.

Scale: 2" = 1 Mile

STATE OF OREGON

County of _____ } ss.

I, _____ being first duly sworn, do hereby certify that I have read the foregoing Registration Statement and that all of the items therein contained are true to the best of my knowledge and belief.

(Signature of Registrant)

Subscribed and sworn to before me this _____ day of _____, 19_____

My commission expires _____ (Notary Public)

(SEAL)

See Page Gr-467 Z-17 for CERTIFICATE OF REGISTRATION

STATE OF OREGON

County of Marion } ss.

~~This is to certify that the foregoing Registration Statement was filed in the office of the State Engineer on the _____ day of _____ 19____ and that the same has been duly recorded in said office in Book No. _____ of Registration Statements on page _____ of said book and that the same shall be completed by _____ and the water completed applied to the _____ by _____ 19____.~~

(State Engineer)

By _____ (Deputy)

