Township 11 S. Range 2 W., W.M.

North

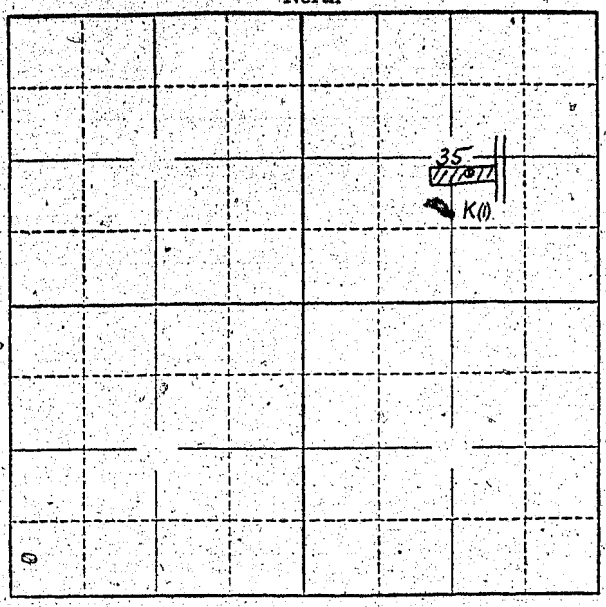

Locate well and acreage of irrigated land on plat.

Scale: 2" = 1 Mile

STATE OF OREGON
County of Linn } ss.

I, Charles H. Theodora G. Bicek, being first duly sworn, do hereby certify that I have read the foregoing Registration Statement and that all of the items therein contained are true to the best of my knowledge and belief.

Theodora G. Bicek
Charles H. Bicek
(Signature of Registrant)

Subscribed and sworn to before me this 11 day of May, 1957.

My commission expires NOTARY PUBLIC FOR OREGON
My Commission Expires Feb. 2, 1960

Robert A. Nevins
(Notary Public)

(SEAL)

CERTIFICATE OF REGISTRATION

STATE OF OREGON
County of Marion } ss.

This is to certify that the foregoing Registration Statement was received in the office of the State Engineer on the 21st day of May, 1957, at 8:00 o'clock A. M. and has been duly recorded in said office in Book No. 3 of Registration Statements on page GR-475 C

~~XX Construction shall be completed by x-x-x-