

Locate well and acreage of irrigated land on plat.
Scale: 2" = 1 Mile

STATE OF OREGON
County of _____ } ss.

I, _____, being first duly sworn, do hereby certify that I have read the foregoing Registration Statement and that all of the items therein contained are true to the best of my knowledge and belief.

Jack L. Stiles
(Signature of Registrant)

Subscribed and sworn to before me this _____ day of _____, 19____

My commission expires _____ (Notary Public)

(SEAL)

See Page GR-476 K for
CERTIFICATE OF REGISTRATION


STATE OF OREGON
County of Marion } ss.

~~XY This is to certify that the foregoing Registration Statement was received in the office of the State Engineer on the _____ day of _____, 19____ at _____ o'clock _____ and has been duly recorded in said office in Book No. _____ of Registration Statements on page _____~~

Witness my hand this _____ day of _____, 19____

(State Engineer)
By _____
(Deputy)

North

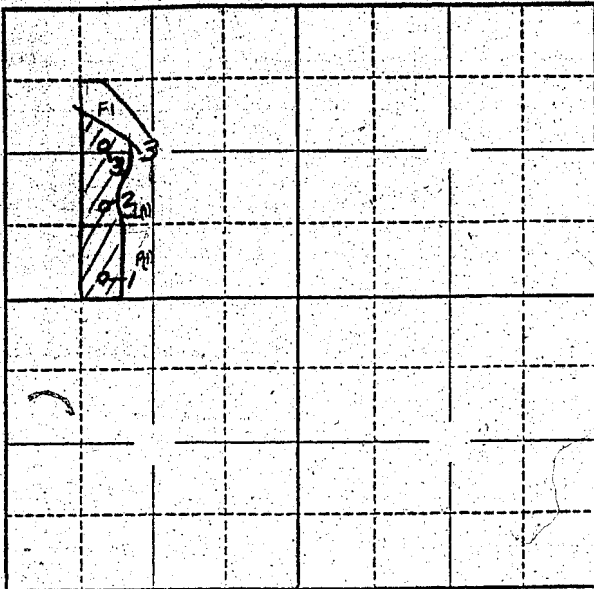

Locate well and acreage of irrigated land on plat.

Scale: 2" = 1 Mile

STATE OF OREGON

County of

} ss.

I,, being first duly sworn, do hereby certify that I have read the foregoing Registration Statement and that all of the items therein contained are true to the best of my knowledge and belief.

Jack L. Stiles
(Signature of Registrant)

Subscribed and sworn to before me this day of, 19.....

My commission expires

(Notary Public)

(SEAL)

See Page GR-476 K for
CERTIFICATE OF REGISTRATION

STATE OF OREGON

County of Marion

} ss.


~~This is to certify that the foregoing Registration Statement was received in the office of the State Engineer on the X-X-X-X day of X-X-X-X-X-X-X-X-X-X, 19XX, at X-X-X-X-X-X-X-X-X-X and has been duly recorded in said office in Book No. X-X-X-X-X of Registration Statements on page X-X-X-X-X-X-X-X.~~

Witness my hand this day of, 19.....

(State Engineer)

By

(Deputy)

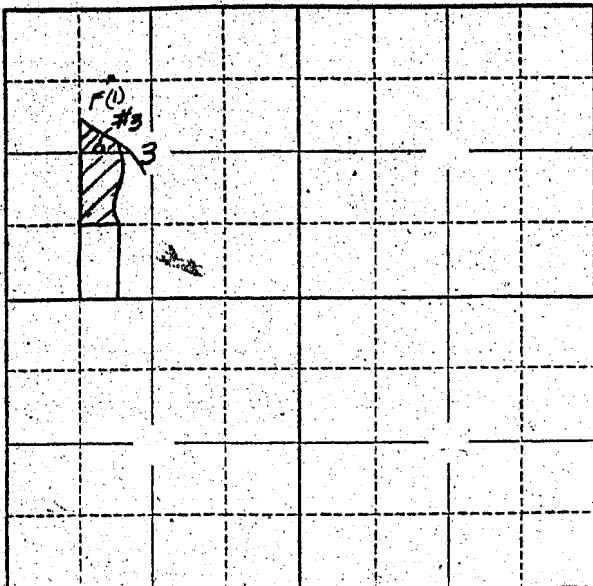

Locate well and acreage of irrigated land on plat.

Scale: 2" = 1 Mile

STATE OF OREGON

County of Marion } ss.

I, Jack L. Stiles, being first duly sworn, do hereby certify that I have read the foregoing Registration Statement and that all of the items therein contained are true to the best of my knowledge and belief.

Jack L. Stiles
(Signature of Registrant)

Subscribed and sworn to before me this 21st day of May, 19 57

My commission expires Sept. 8, 1960 [Signature]
(Notary Public)

(SEAL)

CERTIFICATE OF REGISTRATION

STATE OF OREGON }
County of Marion } ss.

This is to certify that the foregoing Registration Statement was received in the office of the State Engineer on the 21st day of May, 19 57, at 4:30 o'clock P. M. and has been duly recorded in said office in Book No. 3 of Registration Statements on page GR-476 K.

Witness my hand this 26th day of June, 19 57.
Lawrence A. Stanley
(State Engineer)

#16.50

By _____
(Deputy)