


North

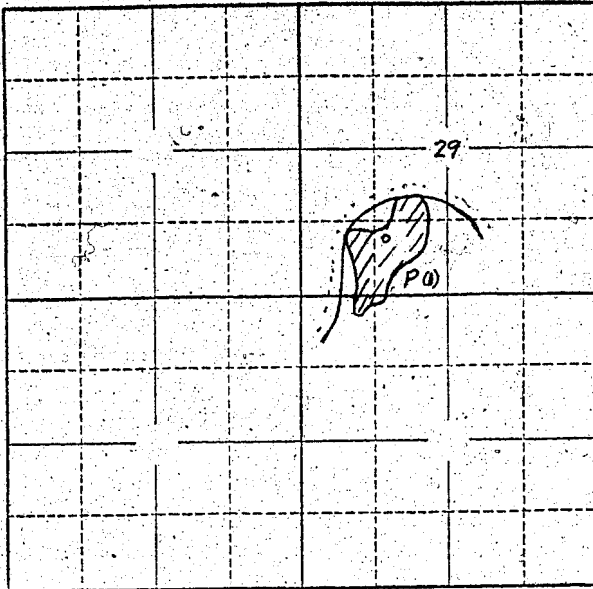

Locate well and acreage of irrigated land on plat.

Scale: 2" = 1 Mile

STATE OF OREGON

County of LINN } ss.

I, FRANK CONSTANCE HENNINGSEN, being first duly sworn, do hereby certify that I have read the foregoing Registration Statement and that all of the items therein contained are true to the best of my knowledge and belief.

(Signature of Registrant)

Subscribed and sworn to before me this ... day of ..., 19...

My commission expires ... (Notary Public)

(SEAL)

See Page GR-479 0 for CERTIFICATE OF REGISTRATION


STATE OF OREGON } ss. County of Marion

This is to certify that the foregoing Registration Statement was received in the office of the State Engineer on the ... day of ... 19... and has been duly recorded in said office in Book No. ... of Registration Statements on page ... Construction shall be completed by ... and the water completely applied for beneficial use by ...

Witness my hand this ... day of ..., 19...

(State Engineer)

By ... (Deputy)

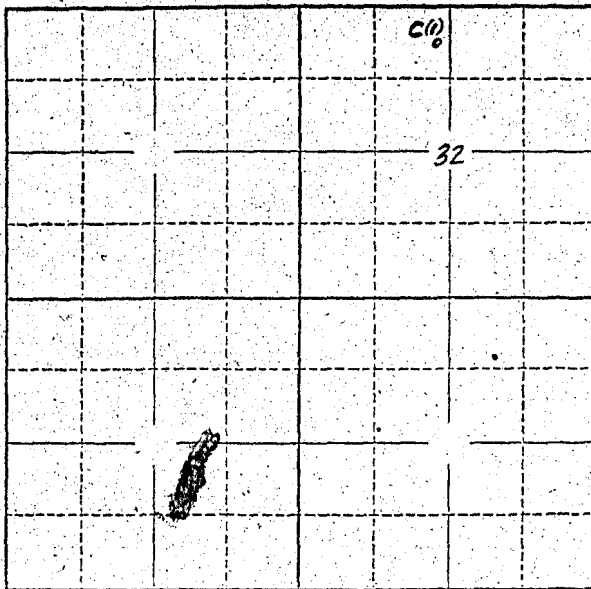

Locate well and acreage of irrigated land on plat.

Scale: 2" = 1 Mile

STATE OF OREGON

County of Linn } ss.

I, E. B. AND CONSTANCE HENNINGSEN, being first duly sworn, do hereby certify that I have read the foregoing Registration Statement and that all of the items therein contained are true to the best of my knowledge and belief.

(Signature of Registrant)

Subscribed and sworn to before me this \_\_\_\_\_ day of \_\_\_\_\_, 19\_\_\_\_.

My commission expires \_\_\_\_\_ (Notary Public)

(SEAL)

See Page GR-479 0 for  
**CERTIFICATE OF REGISTRATION**

STATE OF OREGON }  
County of Marion } ss.

~~This is to certify that the foregoing Registration Statement was received in the office of the State Engineer on the \_\_\_\_\_ day of \_\_\_\_\_ 19\_\_\_\_ at \_\_\_\_\_ o'clock \_\_\_\_\_ and has been duly recorded in said office in Book No. \_\_\_\_\_ of Registration Statements on page \_\_\_\_\_.~~


~~Construction shall be completed by \_\_\_\_\_ and the water completely applied to beneficial use by \_\_\_\_\_.~~

Witness my hand this \_\_\_\_\_ day of \_\_\_\_\_, 19\_\_\_\_.

(State Engineer)

By \_\_\_\_\_ (Deputy)

North

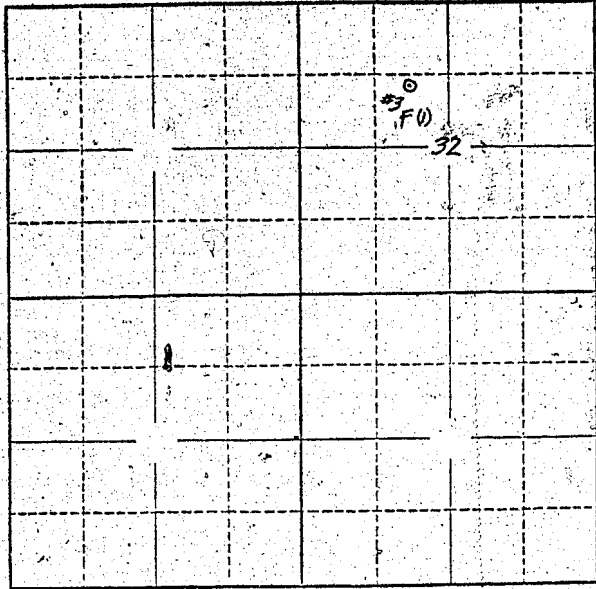

Locate well and acreage of irrigated land on plat.  
Scale: 2" = 1 Mile

STATE OF OREGON

County of Linn } ss.

I, E. B. AND CONSTANCE HENNINGSEN, being first duly sworn, do hereby certify that I have read the foregoing Registration Statement and that all of the items therein contained are true to the best of my knowledge and belief.

.....  
(Signature of Registrant)

Subscribed and sworn to before me this ..... day of ..... 19.....

My commission expires .....  
(Notary Public)

(SEAL)

See Page GR-470 O for  
**CERTIFICATE OF REGISTRATION**

STATE OF OREGON } ss.  
County of Marion


X V. This is to certify that the foregoing Registration Statement was received in the office of the State Engineer on the            day of            19     and has been duly recorded in said office in Book No.            of Registration Statements on page           

Construction shall be completed by            and the water completely applied to beneficial use by           

Witness my hand this ..... day of ..... 19.....

.....  
(State Engineer)

By .....  
(Deputy)

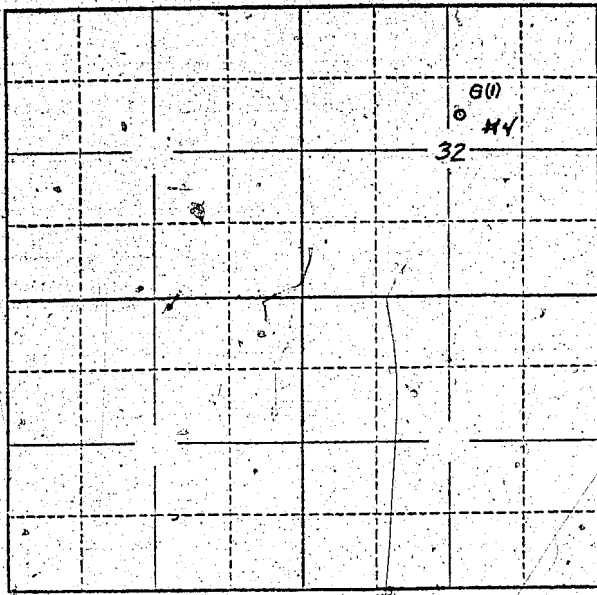

Locate well and acreage of irrigated land on plat.  
Scale: 2" = 1 Mile

STATE OF OREGON

County of Linn } ss.

I. E. B. AND CONSTANCE HENNINGSEN, being first duly sworn, do hereby certify that I have read the foregoing Registration Statement and that all of the items therein contained are true to the best of my knowledge and belief.

*E. B. Henningsen*  
(Signature of Registrant)

Subscribed and sworn to before me this 22 day of May, 1957.

My commission expires Sept. 8, 1960 *Chas. J. Miller*  
(Notary Public)

(SEAL)

**CERTIFICATE OF REGISTRATION**

STATE OF OREGON } ss.  
County of Marion

This is to certify that the foregoing Registration Statement was received in the office of the State Engineer on the 22nd day of May, 1957, at 11:00 o'clock A. M. and has been duly recorded in said office in Book No. 3 of Registration Statements on page GR-479 K.

~~Construction shall be completed by x-x-x-x-x-x-x-x-x-x-19-x-x and the water completely applied to beneficial use by x-x-x-x-x-x-x-x-x-x-19-x-x-x-x~~

Witness my hand this 26th day of June, 1957.

*Lewis A. Stanley*  
(State Engineer)

\$ 27.20

By \_\_\_\_\_ (Deputy)