


North

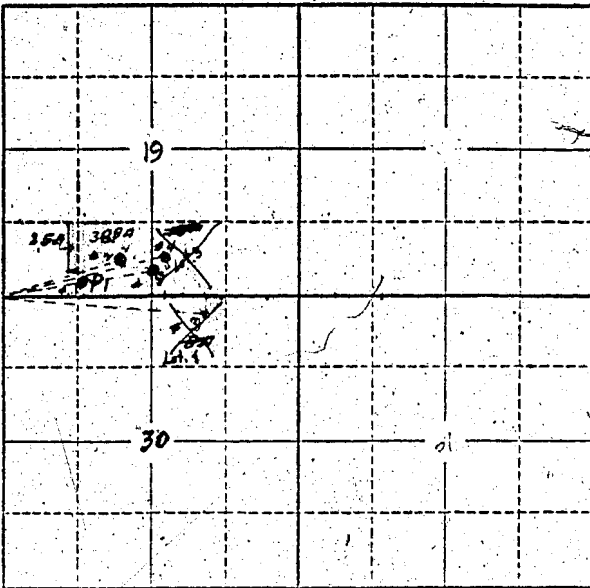

Locate well and acreage of irrigated land on plat.

Scale: 2" = 1 Mile

STATE OF OREGON

County of Marion } ss.

I, Delbert Sandner, being first duly sworn, do hereby certify that I have read the foregoing Registration Statement and that all of the items therein contained are true to the best of my knowledge and belief.

Delbert Sandner
(Signature of Registrant)

Subscribed and sworn to before me this 16 day of May, 1957.

My commission expires 4/21/58

Henry J. Peck
(Notary Public)

(SEAL)

See Page GR-547-G for
CERTIFICATE OF REGISTRATION

STATE OF OREGON }
County of Marion } ss.

~~This is to certify that the foregoing Registration Statement was received in the office of the State Engineer and that the same has been duly recorded in accordance with the provisions of the Registration Act and that the same is a true and correct copy of the original as the same appears on the records of the State Engineer.~~


~~Construction shall be completed by 10 and the rates completely applied to beneficial uses 10~~

~~Witness my hand this 16 day of May 1957~~

(State Engineer)

By _____
(Deputy)

North

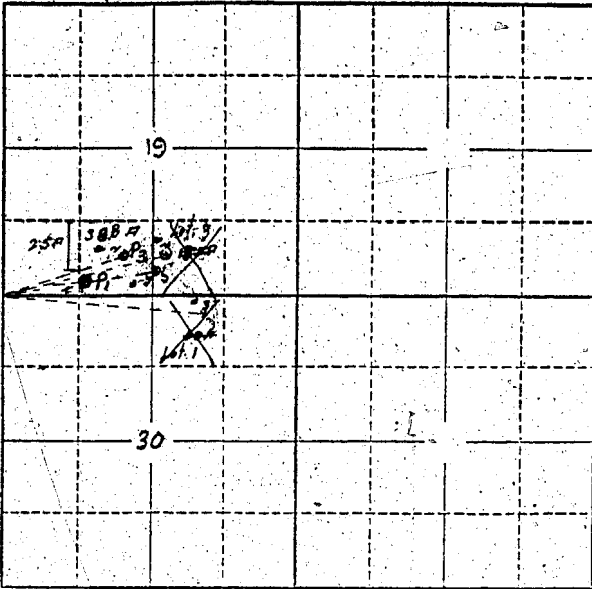

Locate well and acreage of irrigated land on plat.

Scale: 2" = 1 Mile

STATE OF OREGON

County of Marion } ss.

I, Delbert Sandner, being first duly sworn, do hereby certify that I have read the foregoing Registration Statement and that all of the items therein contained are true to the best of my knowledge and belief.

Delbert Sandner
(Signature of Registrant)

Subscribed and sworn to before me this 16 day of May, 1957.

My commission expires 9/21/58 John W. Lee
(Notary Public)

(SEAL)

CERTIFICATE OF REGISTRATION

STATE OF OREGON }
County of Marion } ss.

This is to certify that the foregoing Registration Statement was received in the office of the State Engineer on the 17th day of May, 1957, at 8:00 o'clock A. M. and has been duly recorded in said office in Book No. 4 of Registration Statements on page GR-547 G.

Witness my hand this 13th day of September, 1957.
Lewis J. Strickland
(State Engineer)

By _____ (Deputy)
GR-547 G

\$16.30