


Township 11 S Range 3 W, W.M.
North

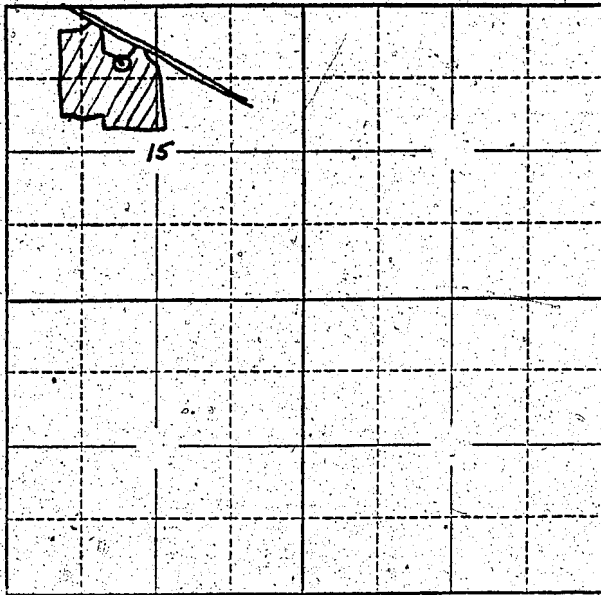

Locate well and acreage of irrigated land on plat.
Scale: 2" = 1 Mile

STATE OF OREGON

County of Linn } ss.

I, Sam Kennel, being first duly sworn, do hereby certify that I have read the foregoing Registration Statement and that all of the items therein contained are true to the best of my knowledge and belief.

Sam Kennel
(Signature of Registrant)

Subscribed and sworn to before me this 27th day of November, 1955.

My commission expires
(SEAL) R. M. Russell, Clerk
Ray H. Magat, Deputy
(Notary Public)

CERTIFICATE OF REGISTRATION

STATE OF OREGON } ss.
County of Marion

This is to certify that the foregoing Registration Statement was received in the office of the State Engineer on the 1st day of December, 1955, at 11:00 o'clock A. M. and has been duly recorded in said office in Book No. 1 of Registration Statements on page 43.

Construction shall be completed by 15 19, and the water 15 completely applied to beneficial use by 19.

Witness my hand this 24th day of February, 1956.
Lewis A. Stanley
(State Engineer)

By
(Deputy)