


North

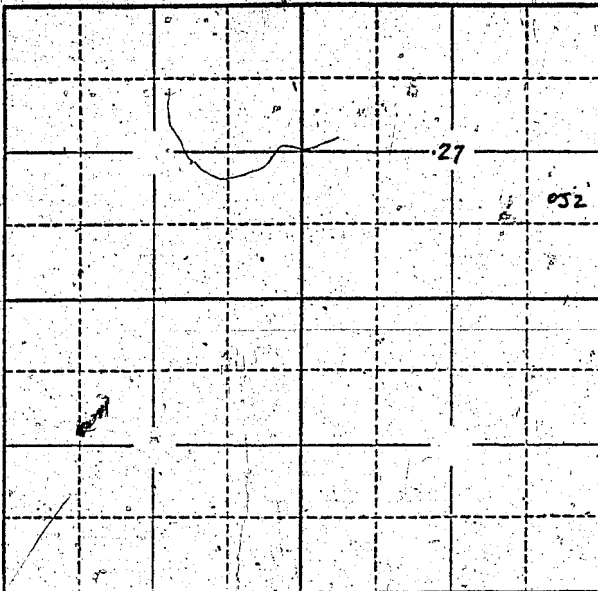

Locate well and acreage of irrigated land on plat.

Scale: 2" = 1 Mile

STATE OF OREGON

County of Linn

} ss.

I, George Stroda, being first duly sworn, do hereby certify that I have read the foregoing Registration Statement and that all of the items therein contained are true to the best of my knowledge and belief.

*George Stroda*  
(Signature of Registrant)

Subscribed and sworn to before me this 11<sup>th</sup> day of June 1957

My commission expires Oct 1, 1958

*Constance D. ...*  
(Notary Public)

(SEAL)

CERTIFICATE OF REGISTRATION

STATE OF OREGON

County of Marion

} ss.

This is to certify that the foregoing Registration Statement was received in the office of the State Engineer on the 13th day of June 1957, at 8:00 o'clock A.M. and has been duly recorded in said office in Book No. 3 of Registration Statements on page GR-195 C.

Witness my hand this 24th day of July 1957

*Lewis A. Stanley*  
(State Engineer)

By

(Deputy)