


Township 10S Range 2W, W.M.
North

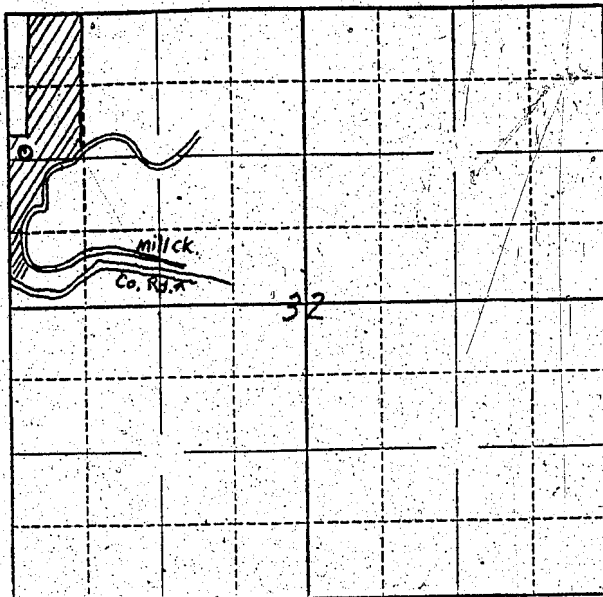

Locate well and acreage of irrigated land on plat.

Scale: $\frac{1}{4}$ " = 1 Mile

STATE OF OREGON

County of Linn

} ss.

I, Sam Kennel, being first duly sworn, do hereby certify that I have read the foregoing Registration Statement and that all of the items therein contained are true to the best of my knowledge and belief.

Sam Kennel
(Signature of Registrant)

Subscribed and sworn to before me this 29th day of November, 1954

My commission expires _____

R. M. Russell
By Ed. Magart, Deputy
(Notary Public)

(SEAL)

CERTIFICATE OF REGISTRATION

STATE OF OREGON

County of Marion

} ss.

This is to certify that the foregoing Registration Statement was received in the office of the State Engineer on the 1st day of December, 1955, at 11:00 o'clock P. M. and has been duly recorded in said office in Book No. 1 of Registration Statements on page 44

Construction shall be completed by _____, 19____, and the water completely applied to beneficial use by _____, 19____

Witness my hand this 24th day of February, 1956

Lewis A. Stanley
(State Engineer)

By _____

(Deputy)

GR-44 C