S. 7, Township 8 S Range 3 W, W.M.

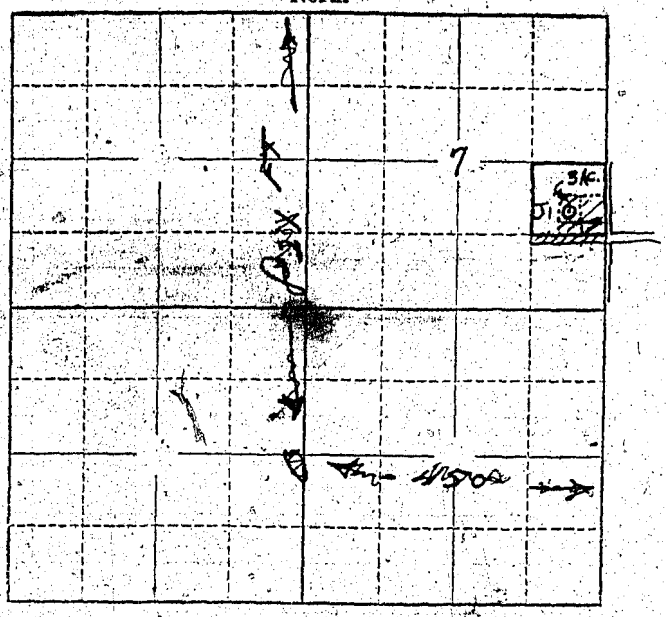

Locate well and acreage of irrigated land on plat.

Scale: 2" = 1 Mile

STATE OF OREGON
County of Marion } ss.

I, Sarah Agalzoff, being first duly sworn, do hereby certify that I have read the foregoing Registration Statement and that all of the items therein contained are true to the best of my knowledge and belief.

Sarah Agalzoff
(Signature of Registrant)

Subscribed and sworn to before me this 17th day of June, 19 57

My commission expires June 12th 1969

Wm. S. Bartholomew
(Notary Public)

(SEAL)

CERTIFICATE OF REGISTRATION

STATE OF OREGON
County of Marion } ss.

This is to certify that the foregoing Registration Statement was received in the office of the State Engineer on the 17th day of June, 19 57, at 9:00 o'clock A. M. and has been duly recorded in said office in Book No. 3 of Registration Statements on page GR-498 C

~~Construction shall be completed by x-x-x-x-x-x-x-x-x-x-10-x-x, and the use be completely applied to beneficial use by x-x-x-x-x-x-x-x-x-x-11-x-x~~

Witness my hand this 24th day of July, 19 57

Lewis A. Stanley
(State Engineer)

$1.50

By
(Deputy)