


North

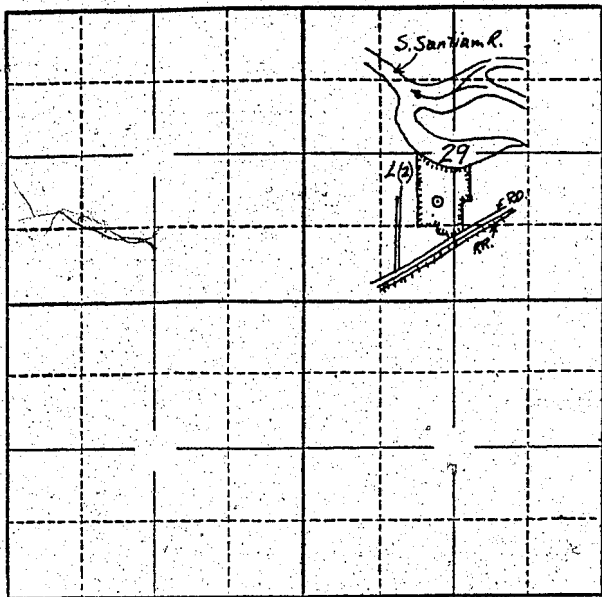

Locate well and acreage of irrigated land on plat.

Scale: 2" = 1 Mile

STATE OF OREGON

County of Linn } ss.

I, Elijah Hayes, being first duly sworn, do hereby certify that I have read the foregoing Registration Statement and that all of the items therein contained are true to the best of my knowledge and belief.

Elijah Hayes  
(Signature of Registrant)

Subscribed and sworn to before me this 13<sup>th</sup> day of June, 1957

My commission expires \_\_\_\_\_ R. M. RUSSELL, COUNTY CLERK

(Notary Public)

(SEAL)

By

Gladis J. Russell  
Deputy

**CERTIFICATE OF REGISTRATION**

STATE OF OREGON } ss.  
County of Marion

This is to certify that the foregoing Registration Statement was received in the office of the State Engineer on the 10<sup>th</sup> day of June, 1957 at 8:00 o'clock A. M. and has been duly recorded in said office in Book No. 3 of Registration Statements on page GR-500 C

Witness my hand this 2<sup>th</sup> day of July, 1957

Leuro A. Stanley  
(State Engineer)

By \_\_\_\_\_ (Deputy)

\$15.00