Township 12 S Range 4 W, W.M.

North

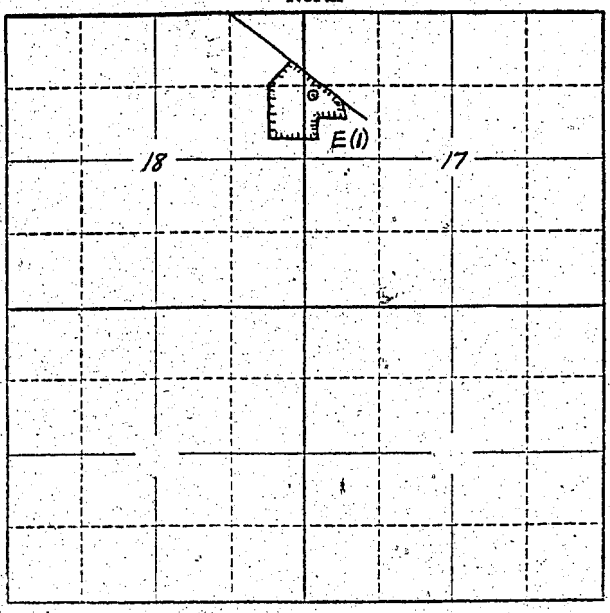

Locate well and acreage of irrigated land on plat.

Scale: 2" = 1 Mile

STATE OF OREGON)
County of Linn) ss.

I, F. M. & Floy O. Lamb, being first duly sworn, do hereby certify that I have read the foregoing Registration Statement and that all of the items therein contained are true to the best of my knowledge and belief.

Floy O. Lamb
F M Lamb
(Signature of Registrant)

Subscribed and sworn to before me this 14th day of June, 19 57

My commission expires April 21, 1961

Frank Harding
(Notary Public)

(SEAL)

CERTIFICATE OF REGISTRATION

STATE OF OREGON)
County of Marion) ss.

This is to certify that the foregoing Registration Statement was received in the office of the State Engineer on the 24th day of June, 19 57, at 8:00 o'clock A. M. and has been duly recorded in said office in Book No. 3 of Registration Statements on page GR-505 C

~~Certificate of Completion issued by~~ ~~Certificate of Completion applied to~~ ~~Certificate of Permit to Appropriate~~ ~~issued by~~

Witness my hand this 24th day of July, 19 57.

Lewis A. Stanley
(State Engineer)

15.00

By
(Deputy)

GR-505 C