


Township 1 N Range 3 W W.M.

North

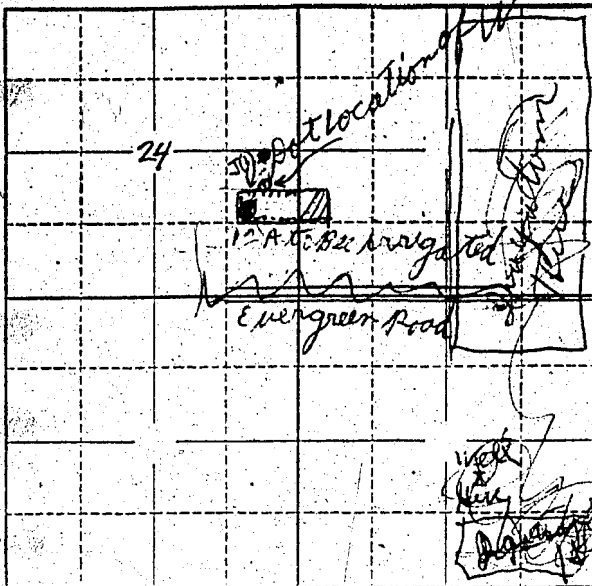

Locate well and acreage of irrigated land on plat.

Scale: 2" = 1 Mile

STATE OF OREGON

County of Washington

SS.

I, Geo. Zimmerman, being first duly sworn, do hereby certify that I have read the foregoing Registration Statement and that all of the items therein contained are true to the best of my knowledge and belief.

Geo. Zimmerman
(Signature of Registrant)

Subscribed and sworn to before me this 6th. day of Sept. 1956

My commission expires 9-6-58.

Notary Public
(Notary Public)

(SEAL)

NOTARY PUBLIC
My Commission Expires Sept. 6, 1958

CERTIFICATE OF REGISTRATION

STATE OF OREGON

County of Marion

SS.

This is to certify that the foregoing Registration Statement was received in the office of the State Engineer on the 26th day of June, 1957, at 8:00 o'clock A. M. and has been duly recorded in said office in Book No. 4 of Registration Statements on page GR-574 C.

~~Construction shall be completed by X-X-X-X-X-X-X-X-X-X-X-X-X-X-X-X 19-57 and the water completely applied to beneficial use by X-X-X-X-X-X-X-X-X-X-X-X-X-X-X-X 19-XX~~

Witness my hand this 16th day of October, 1957.

Lewis A. Stoney
(State Engineer)

By _____ (Deputy)

\$ 15.00

GR-574 C