


North

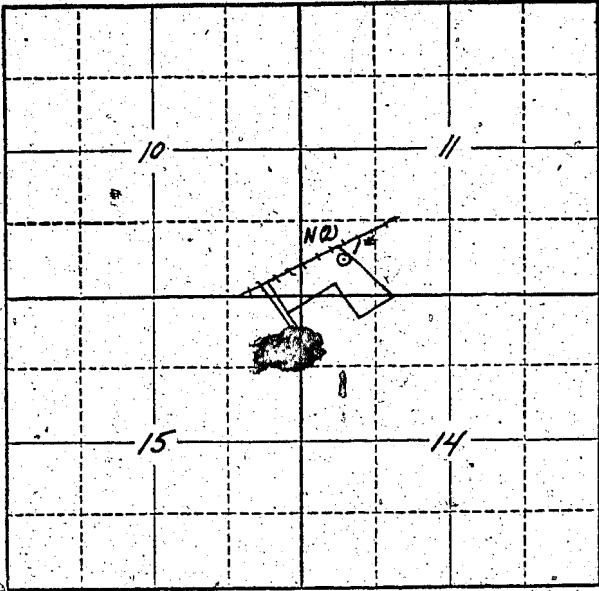

Locate well and acreage of irrigated land on plat.  
Scale: 2" = 1 Mile

STATE OF OREGON

County of Linn } ss.

I, Clara C. Kizer, being first duly sworn, do hereby certify that I have read the foregoing Registration Statement and that all of the items therein contained are true to the best of my knowledge and belief.

Clara C. Kizer  
(Signature of Registrant)

Subscribed and sworn to before me this 27 day of July, 1957

My commission expires

W. H. Russell  
(Notary Public)  
Clara C. Kizer

(SEAL)

CERTIFICATE OF REGISTRATION

STATE OF OREGON } ss.  
County of Marion

This is to certify that the foregoing Registration Statement was received in the office of the State Engineer on the 2nd day of July, 1957 at 8:00 o'clock A.M. and has been duly recorded in said office in Book No. 3 of Registration Statements on page GR-537 C.

Witness my hand this 13th day of September, 1957

Laura A. Stanley  
(State Engineer)

\$15.00

By \_\_\_\_\_ (Deputy)