


Township 7 Range 24 N W.M.
North

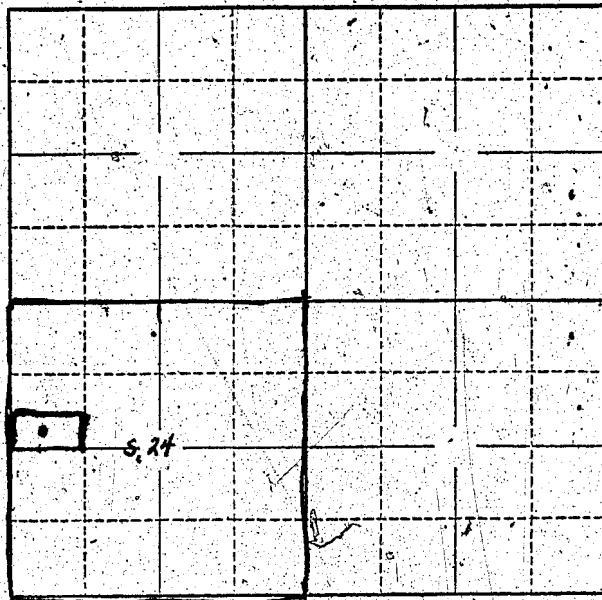

Locate well and acreage of irrigated land on plat.
Scale: 2" = 1 Mile

STATE OF OREGON

County of Marion

} ss.

I, Elery E. Nutter being first duly sworn, do hereby certify that I have read the foregoing Registration Statement and that all of the items therein contained are true to the best of my knowledge and belief.

Elery E. Nutter
(Signature of Registrant)

Subscribed and sworn to before me this 28th day of November, 19 55.

My commission expires 11/12/59

Charles Nelson
(Notary Public)

(SEAL)

CERTIFICATE OF REGISTRATION

STATE OF OREGON

County of Marion

} ss.

This is to certify that the foregoing Registration Statement was received in the office of the State Engineer on the 29th day of November, 19 55, at 8:00 o'clock A. M. and has been duly recorded in said office in Book No. 1 of Registration Statements on page 46.

Construction shall be completed by _____, 19____, and the water completely applied to beneficial use by _____, 19____.

Witness my hand this 24th day of February, 19 56.

Lewis A. Stanley
(State Engineer)

By _____
(Deputy)