


North

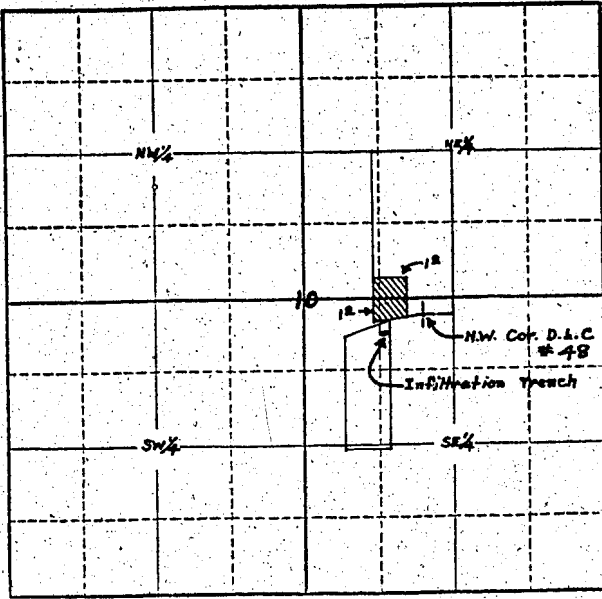

Locate well and acreage of irrigated land on plat.

Scale: 4" = 1 Mile

STATE OF OREGON

County of Jackson

*Jackson*

ss.

I, *Allen D. Croucher*, being first duly sworn, do hereby certify that I have read the foregoing Registration Statement and that all of the items therein contained are true to the best of my knowledge and belief.

*Allen D. Croucher*  
(Signature of Registrant)

Subscribed and sworn to before me this *12th* day of *July*, 19 *57*

My commission expires *Nov. 23-1960*

*Jay Paul Neil*  
(Notary Public for Oregon)

(SEAL)

**CERTIFICATE OF REGISTRATION**

STATE OF OREGON

County of Marion

ss.

This is to certify that the foregoing Registration Statement was received in the office of the State Engineer on the *8th* day of *July*, 19 *57*, at *8:00* o'clock *A.* M. and has been duly recorded in said office in Book No. *3* of Registration Statements on page *GR-516 C*

Witness my hand this *24th* day of *July*, 19 *57*

*Lewis A. Stanley*  
(State Engineer)

By \_\_\_\_\_ (Deputy)

\$15.00