


Township 7 S Range 3 W W.M.

North

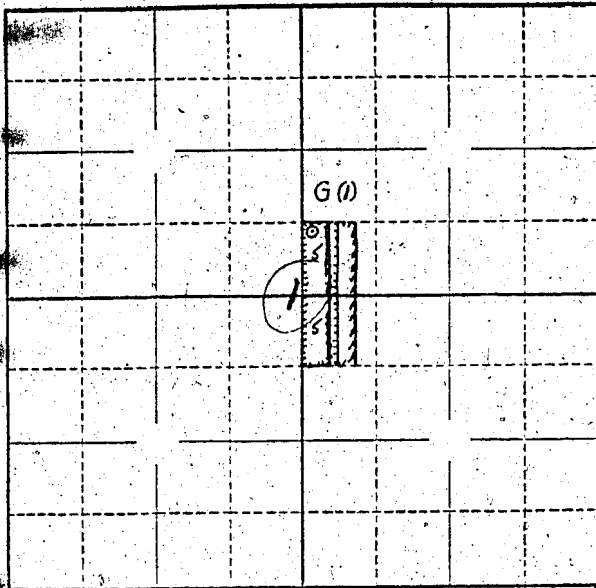

Locate well and acreage of irrigated land on plat.

Scale: $\frac{2''}{4''} = 1 \text{ Mile}$

STATE OF OREGON

County of Marion } ss.

I, Gilbert Sneed, being first duly sworn, do hereby certify that I have read the foregoing Registration Statement and that all of the items therein contained are true to the best of my knowledge and belief.

Gilbert Sneed
(Signature of Registrant)

Subscribed and sworn to before me this 10th day of July, 1957.

My commission expires June 12, 1961 Wm. S. Bartholomew
(Notary Public)

(SEAL)

CERTIFICATE OF REGISTRATION

STATE OF OREGON

County of Marion } ss.

This is to certify that the foregoing Registration Statement was received in the office of the State Engineer on the 10th day of July, 1957, at 10:30 o'clock A. M. and has been duly recorded in said office in Book No. 3 of Registration Statements on page GR-520 C.

Witness my hand this 21th day of July, 1957.

Lewis A. Stanley
(State Engineer)

By _____ (Deputy)

GR - 520 C

15⁰⁰