


North

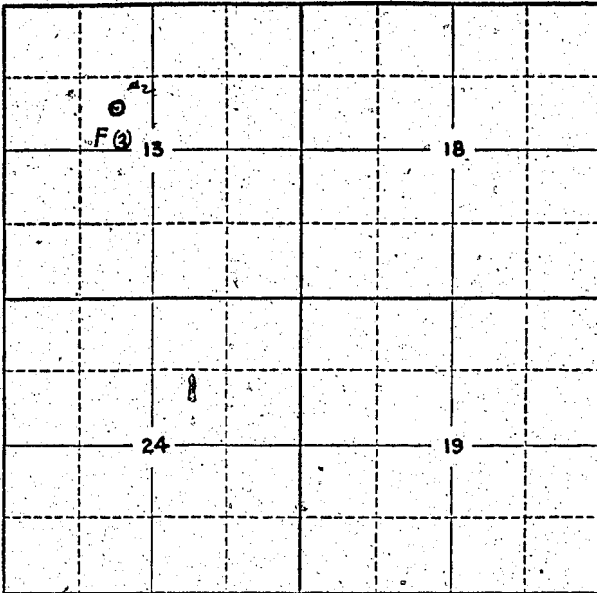

Locate well and acreage of irrigated land on plat.

Scale: 2" = 1 Mile

STATE OF OREGON

County of Lane } ss.

Daniel O. Potter, City Recorder

I, City of Eugene, Lane Co., Oregon

being first duly sworn, do hereby certify that I have read the foregoing Registration Statement and that all of the items therein contained are true to the best of my knowledge and belief.

Daniel O. Potter, (Signature of Registrant) City Recorder, City of Eugene

Subscribed and sworn to before me this 9th day of July, 1957

My commission expires Nov 21 1957

(Notary Public)

(SEAL)

CERTIFICATE OF REGISTRATION

STATE OF OREGON } ss.
County of Marion

This is to certify that the foregoing Registration Statement was received in the office of the State Engineer on the 11th day of July, 1957 at 8:00 o'clock A.M. and has been duly recorded in said office in Book No. 3 of Registration Statements on page GR-522 C

Witness my hand this 24th day of July, 1957

(State Engineer)

By (Deputy)