


North

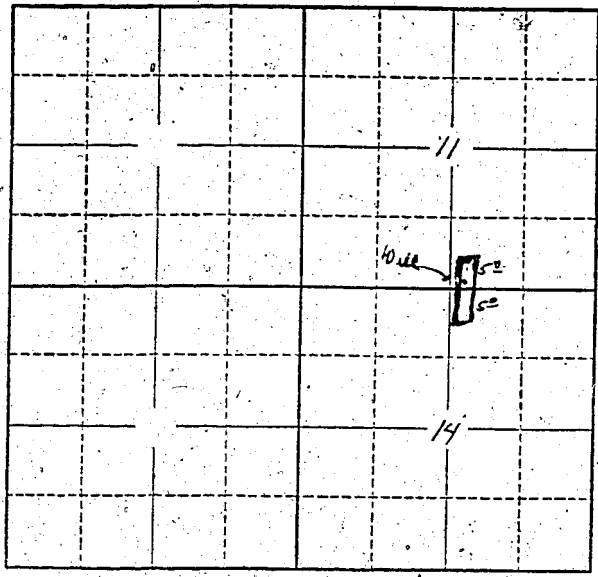

Locate well and acreage of irrigated land on plat.

Scale: ~~1/4~~ - 1 Mile

4

STATE OF OREGON

County of LANE } ss.

I, TYLER J. FENN, being first duly sworn, do hereby certify that I have read the foregoing Registration Statement and that all of the items therein contained are true to the best of my knowledge and belief.

Tyler J. Fenn
(Signature of Registrant)

Subscribed and sworn to before me this 15th day of July, 1957.

My commission expires April 26, 1961.

Thomas P. Henderson
(Notary Public) FOR Oregon

(SEAL)

CERTIFICATE OF REGISTRATION

STATE OF OREGON }
County of Marion } ss.

This is to certify that the foregoing Registration Statement was received in the office of the State Engineer on the 22 day of July, 1957, at 8:00 o'clock A. M. and has been duly recorded in said office in Book No. 7 of Registration Statements on page _____

Witness my hand this 1st day of December, 1958

Laura A. Stanley
(State Engineer)

By _____ (Deputy)

\$15.00