


Section 4

Township 25 Range 12 W.M. North

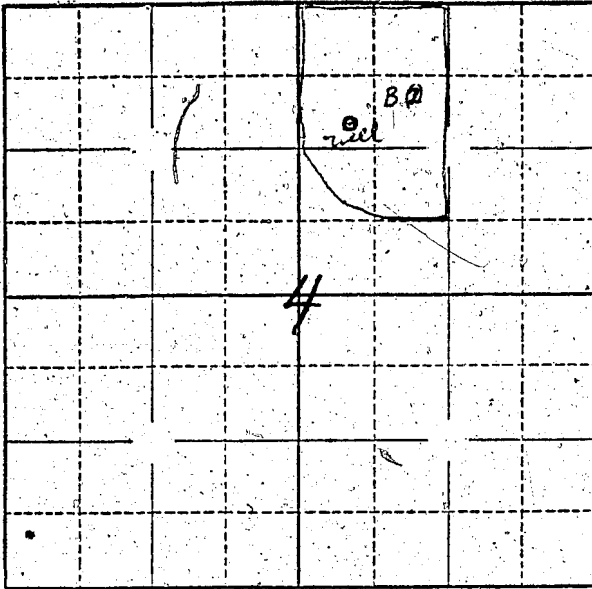

Locate well and acreage of irrigated land on plat.

Scale: 1" = 1 Mile  
4"

STATE OF OREGON

County of Washington } ss.

I, Robert Sunamoto, being first duly sworn, do hereby certify that I have read the foregoing Registration Statement and that all of the items therein contained are true to the best of my knowledge and belief.

*Robert Sunamoto*  
(Signature of Registrant)

Subscribed and sworn to before me this 25th day of July, 1957.

My commission expires August 18, 1960

*A. Vincent*  
(Notary Public for Oregon)

(SEAL)

CERTIFICATE OF REGISTRATION

STATE OF OREGON }  
County of Marion } ss.

This is to certify that the foregoing Registration Statement was received in the office of the State Engineer on the 5th day of August, 1957, at 8:00 o'clock A.M. and has been duly recorded in said office in Book No. 4 of Registration Statements on page GR-548 C.

Witness my hand this 13th day of September, 1957.

*Lewis A. Stanley*  
(State Engineer)

By \_\_\_\_\_ (Deputy)

#19-85

GR - 548 C