


Township 3S Range 1E W.M.  
North

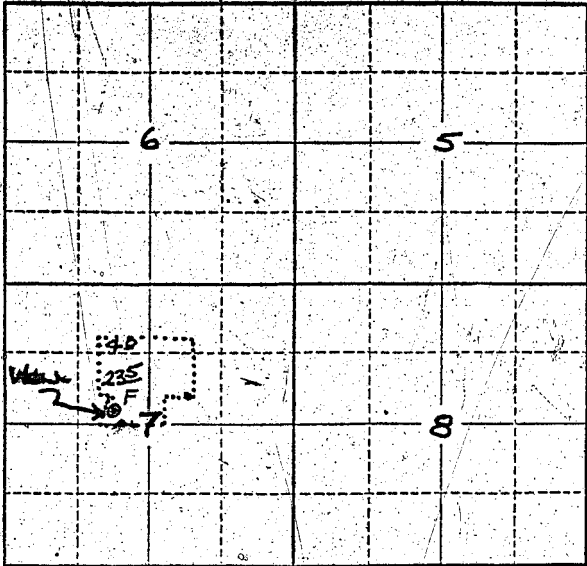

Locate well and acreage of irrigated land on plat.  
Scale: 2" = 1 Mile

STATE OF OREGON

County of Washington } ss.

I, Ernest Kahle, being first duly sworn, do hereby certify that I have read the foregoing Registration Statement and that all of the items therein contained are true to the best of my knowledge and belief.

Ernest Kahle  
(Signature of Registrant)

Subscribed and sworn to before me this 2nd day of July, 1958  
M. LYNN JUDY

My commission expires NOTARY PUBLIC FOR OREGON  
MY COMMISSION EXPIRES DEC. 13, 1960

M. Lynn Judy  
(Notary Public)

(SEAL)

**CERTIFICATE OF REGISTRATION**

STATE OF OREGON

County of Marion } ss.

This is to certify that the foregoing Registration Statement was received in the office of the State Engineer on the 8th day of July, 1958, at 8:00 o'clock A.M. and has been duly recorded in said office in Book No. 11 of Registration Statements on page GR-2438

Witness my hand this 16th day of March, 1959

Laura A. Stanley  
(State Engineer)

By \_\_\_\_\_ (Deputy)

GR. - 2438

\$1500