Township 37 S. Range 2 W., W.M.

North

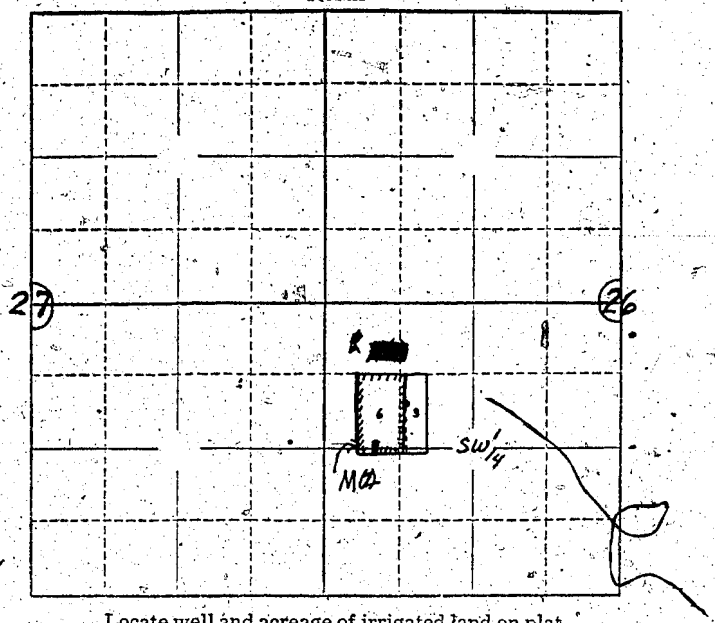

Locate well and acreage of irrigated land on plat.

Scale: 4" = 1 Mile

STATE OF OREGON
County of Jackson } ss.

I, Allan F. Terry, being first duly sworn, do hereby certify that I have read the foregoing Registration Statement and that all of the items therein contained are true to the best of my knowledge and belief.

Terry Dairy Farms
Allan F. Terry
(Signature of Registrant)

Subscribed and sworn to before me this 31st day of August, 1957

My commission expires May 21, 1958

Robert Cunningham
(Notary Public)

(SEAL)

CERTIFICATE OF REGISTRATION

STATE OF OREGON
County of Marion } ss.

This is to certify that the foregoing Registration Statement was received in the office of the State Engineer on the 8th day of August, 19 57, at 1:00 o'clock P. M. and has been duly recorded in said office in Book No. 4 of Registration Statements on page GR-551

~~Construction shall be completed x x x and the water applied to beneficial use by x x x~~

Witness my hand this 13th day of September, 19 57.

Lewis A. Elliott
(State Engineer)

$15.00

By _____ (Deputy)

GR-551 C