


North

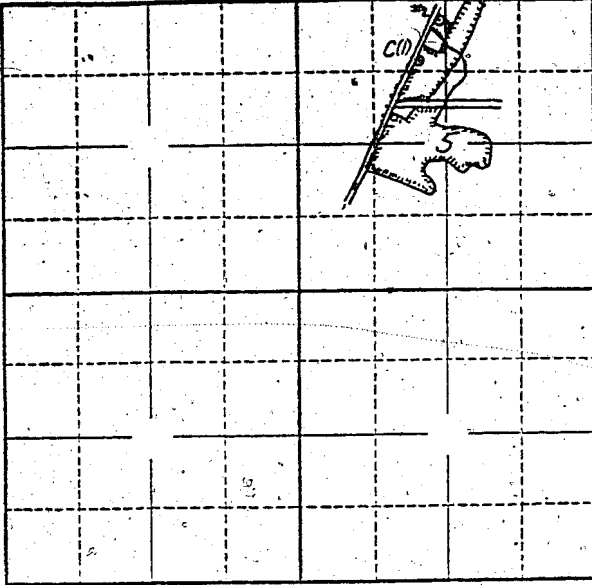

Locate well and acreage of irrigated land on plat.

Scale: 2" = 1 Mile

STATE OF OREGON

County of Linn

} ss.

I, Kyle and Mary Folsom, being first duly sworn, do hereby certify that I have read the foregoing Registration Statement and that all of the items therein contained are true to the best of my knowledge and belief.

Kyle B Folsom
Mary Folsom
 (Signature of Registrant)

Subscribed and sworn to before me this 14th day of June, 1957.

My commission expires May 31 1958

Lela Nelson
 (Notary Public)

(SEAL)

CERTIFICATE OF REGISTRATION

STATE OF OREGON

County of Marion

} ss.

This is to certify that the foregoing Registration Statement was received in the office of the State Engineer on the 13th day of August, 1957, at 8:00 o'clock A. M. and has been duly recorded in said office in Book No. 4 of Registration Statements, page GR-555 C.

Witness my hand this, 13th day of September, 1957.

Lewis A. Stanley
 (State Engineer)

By _____ (Deputy)